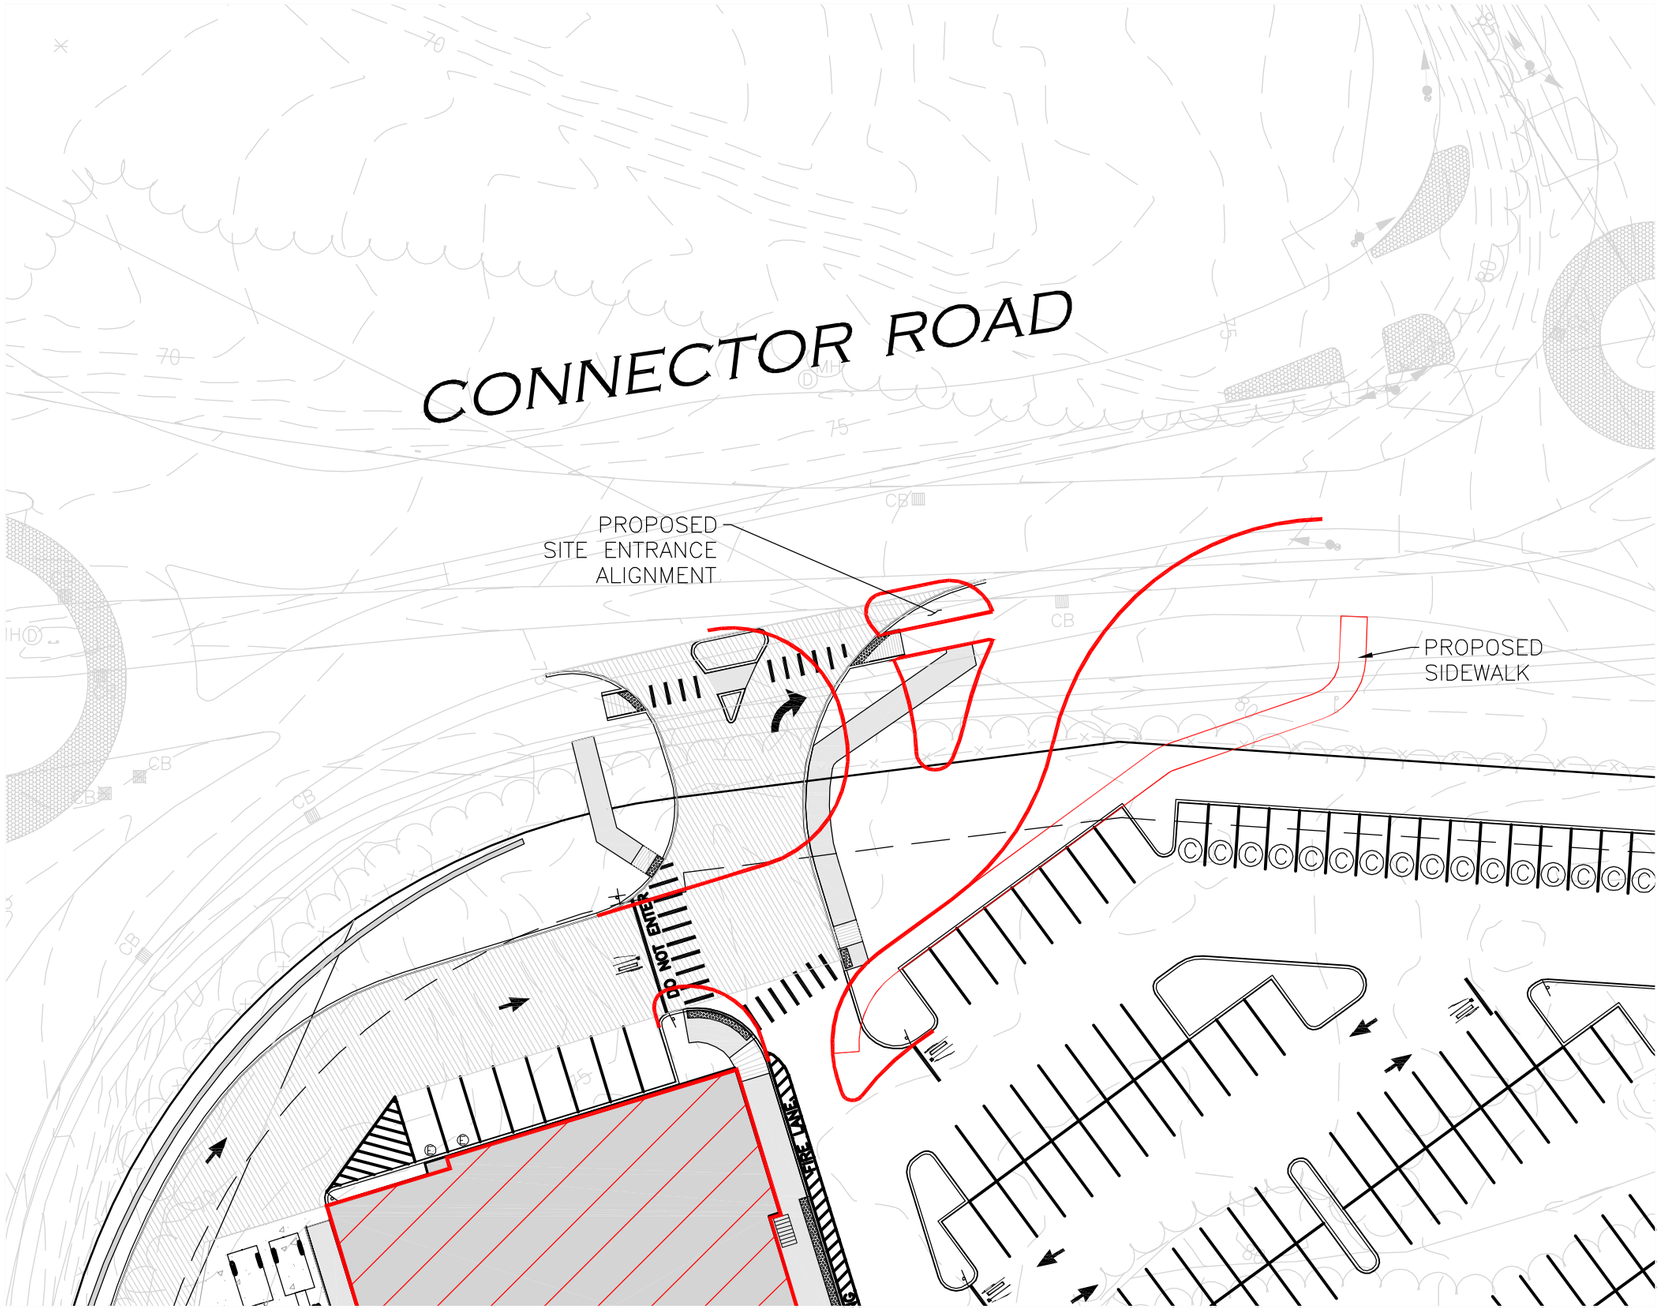

GRAPHIC SCALE

40 0 20 40 80 160

(IN FEET)
1 inch = 40 ft.

N:\PROJECTS\1976-01B\CIVIL\DRAWINGS\CURRENT\ARCHIVE\2015-11-05 - 3 REVISION SKETCHES\C-1976-01B - LAYOUT.DWG

APPLICANT/OWNER:
CEA BEVERLY LLC
1105 MASSACHUSETTS AVENUE
SUITE #2F
CAMBRIDGE, MA 02138

PROJECT:
NORTH SHORE CROSSING
BRIMBAL AVE & SOHIER ROAD
BEVERLY, MA

PROJECT NO.	1976-01B	DATE:	11-06-2015
SCALE:	1" = 40'	DWG. NAME:	C1976-01B
DESIGNED BY:	SJL/RB	CHECKED BY:	CMQ

PREPARED BY:
ALLEN & MAJOR ASSOCIATES, INC.
civil & structural engineering ◆ land surveying
environmental consulting ◆ landscape architecture
www.allenmajor.com
100 COMMERCE WAY
P.O. BOX 2118
WOBURN MA 01888-0118
TEL: (781) 935-6889
FAX: (781) 935-2896
WOBURN, MA ◆ LAKEVILLE, MA ◆ MANCHESTER, NH

THIS DRAWING HAS BEEN PREPARED IN ELECTRONIC FORMAT. CLIENT/CLIENT'S REPRESENTATIVE OR CONSULTANT MAY BE PROVIDED COPIES OF DRAWINGS AND SPECIFICATIONS ON MAGNETIC MEDIA FOR HIS/HER INFORMATION AND USE FOR SPECIFIC APPLICATION TO THIS PROJECT. DUE TO THE POTENTIAL THAT THE MAGNETIC INFORMATION MAY BE MODIFIED UNINTENTIONALLY OR OTHERWISE, ALLEN & MAJOR ASSOCIATES, INC. MAY REMOVE ALL INDICATION OF THE DOCUMENT'S AUTHORSHIP ON THE MAGNETIC MEDIA. PRINTED REPRESENTATIONS OF THE DRAWINGS AND SPECIFICATIONS ISSUED SHALL BE THE ONLY RECORD COPIES OF ALLEN & MAJOR ASSOCIATES, INC.'S WORK PRODUCT.

DRAWING TITLE:
SKETCH #3

SHEET No.
SK-3

Copyright ©2015 Allen & Major Associates, Inc.
All Rights Reserved