No. 5 Country Dr. STREET | APP. No. 7376

E. Mitchell LOCATION OF SERVICE

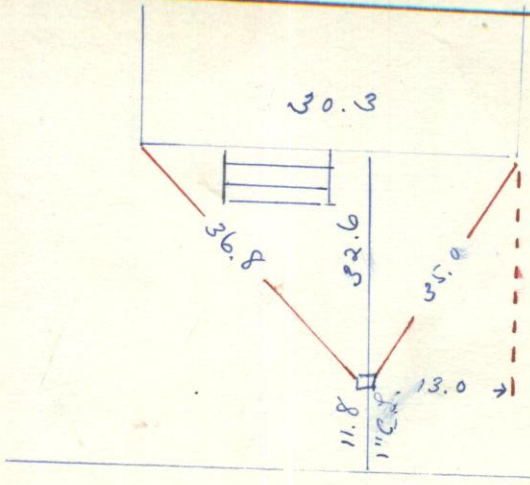

Lot #7

No. 7 Country Ln. STREET | APP. No. 7377

A. Bell LOCATION OF SERVICE (1948)

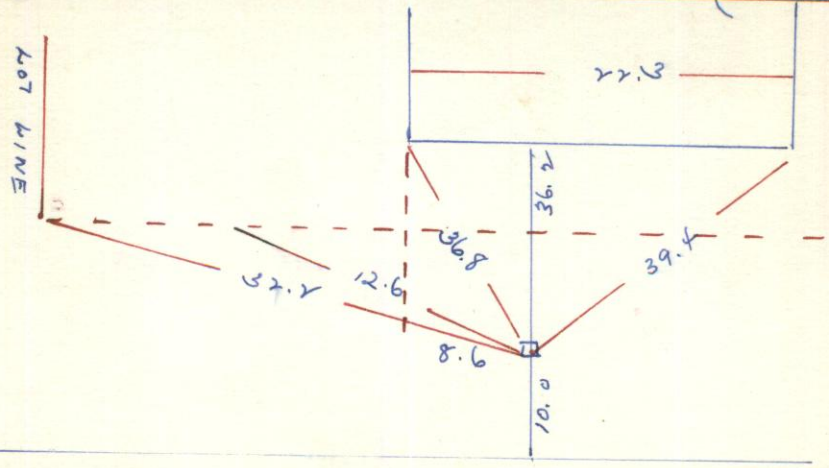

No. 9 Country Drive STREET | APP. No. 7465

LOCATION OF SERVICE

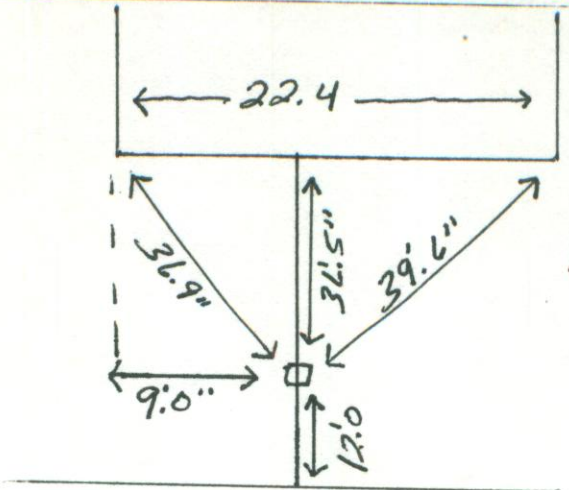

Replaced
3-9-10
1" tap 1" copper
main to House

No. 10 County Dr. STREET | APP. No. 7360

D Wilkins LOCATION OF SERVICE

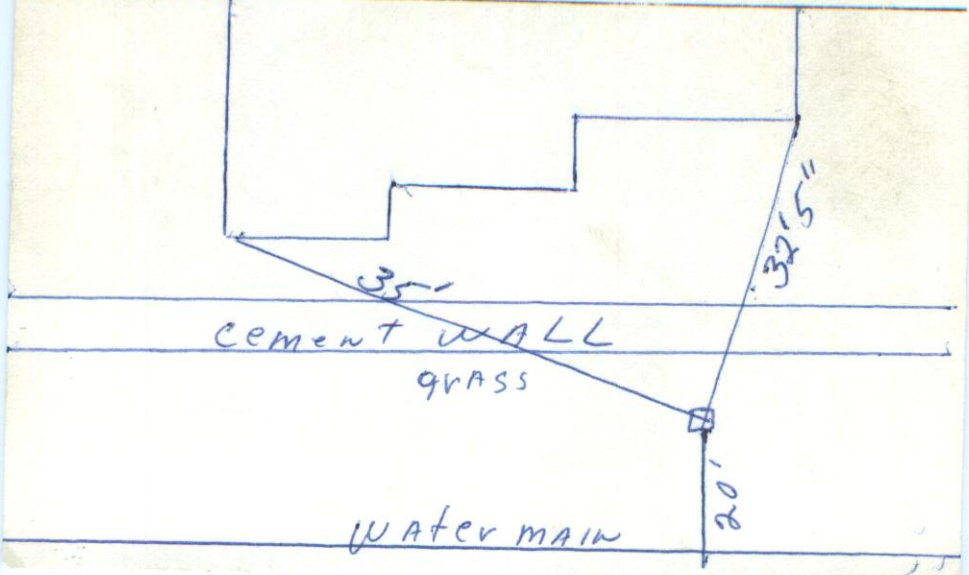

No. 11 Country Dr STREET | APP. NO. 7381

LOCATION OF SERVICE

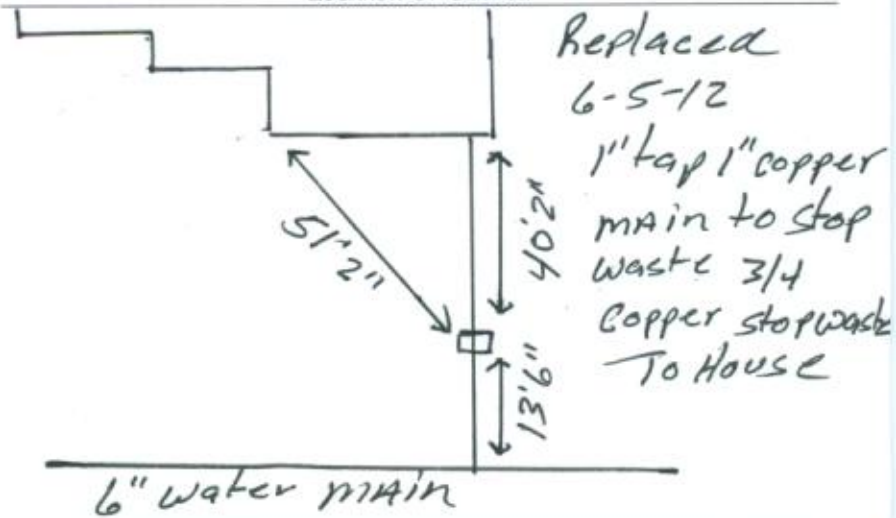

No. 11 Country Dr STREET | APP. No. 7381

C. Mettam LOCATION OF SERVICE (1948)

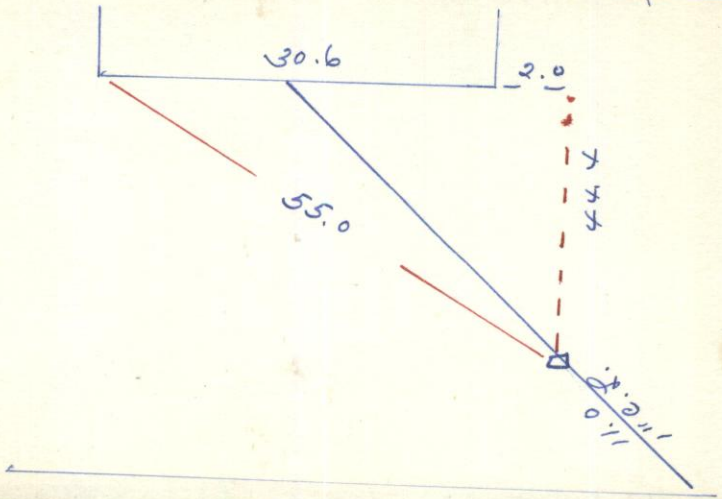

No. 12 Country Klr. STREET | APP. No. 7670

S. Wilkins LOCATION OF SERVICE (1948)

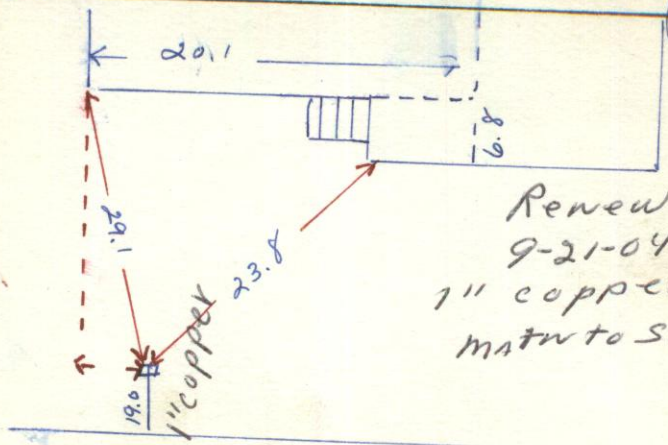

Renewal
9-21-04
1" copper
main to stop

No. 13 Cedarcliff Dr STREET | APP. No. 7380

E. Seems LOCATION OF SERVICE

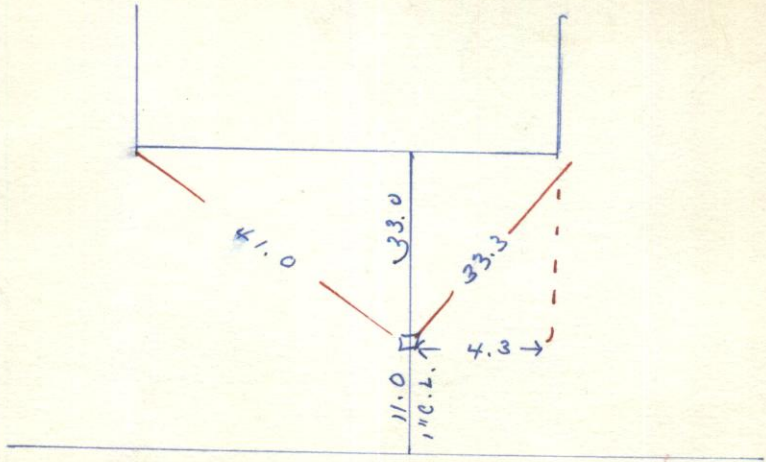

No. 14 Country Cl. STREET | APP. No. 7379

A. Bovio LOCATION OF SERVICE

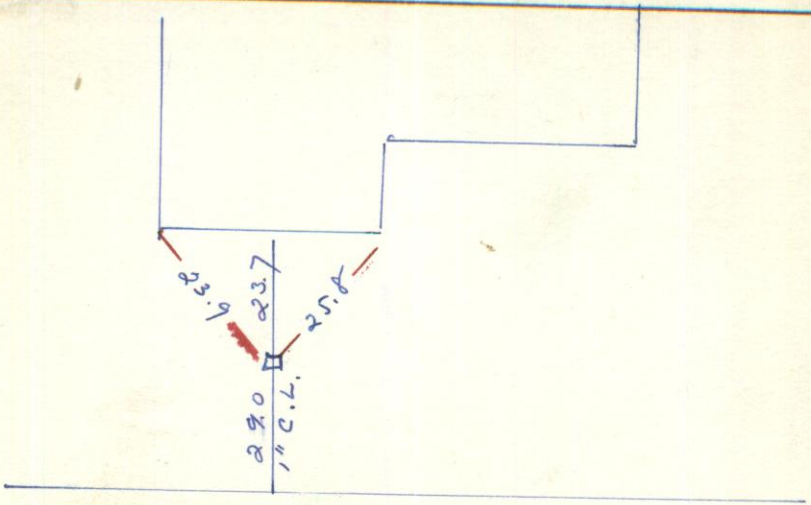

No. 15 Country Drive STREET | APP. No. 7444

LOCATION OF SERVICE 10/8/09

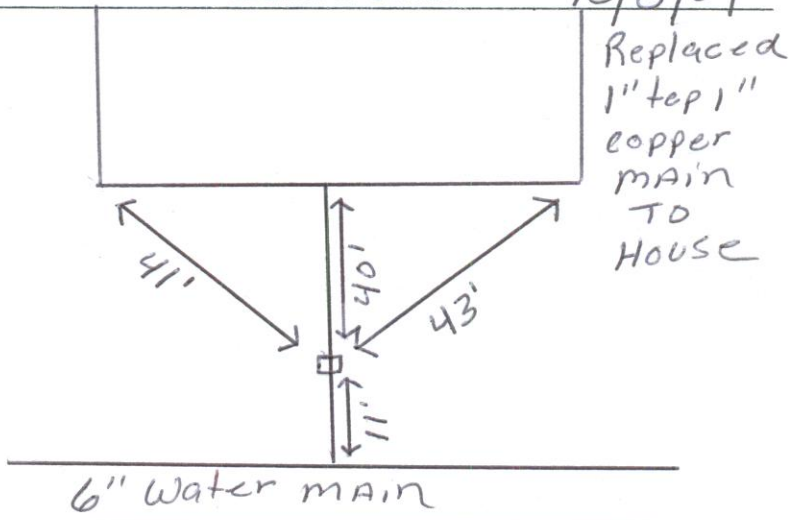

Replaced 1" tap 1" copper main to house

No. 16 Country Drive STREET | APP. No. 10,776

July 22, 1965 LOCATION OF SERVICE Pyburn Constr. Corp.

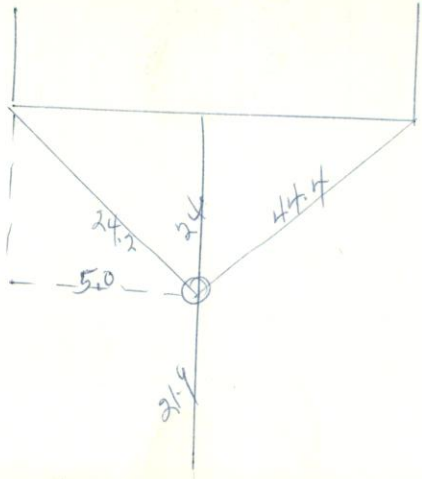

No. 17 Country Dr. STREET | APP. No. 7495

R. Wade LOCATION OF SERVICE (1948)

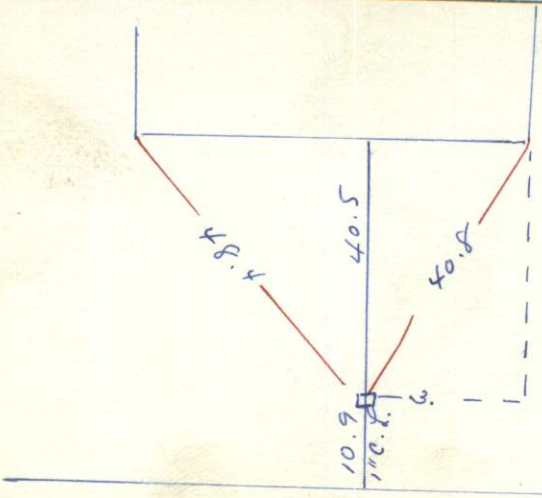

No. 18 Country Dr STREET | APP. No. 7434

W. Yarrison LOCATION OF SERVICE (1948)

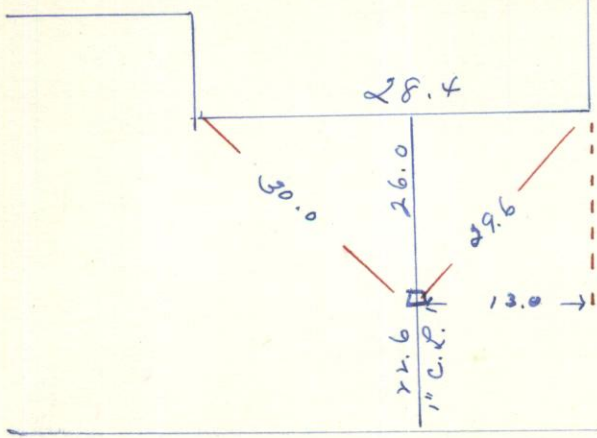

No. 19 Coventry Dr. STREET | APP. No. 7443

N. Gray LOCATION OF SERVICE (1948)

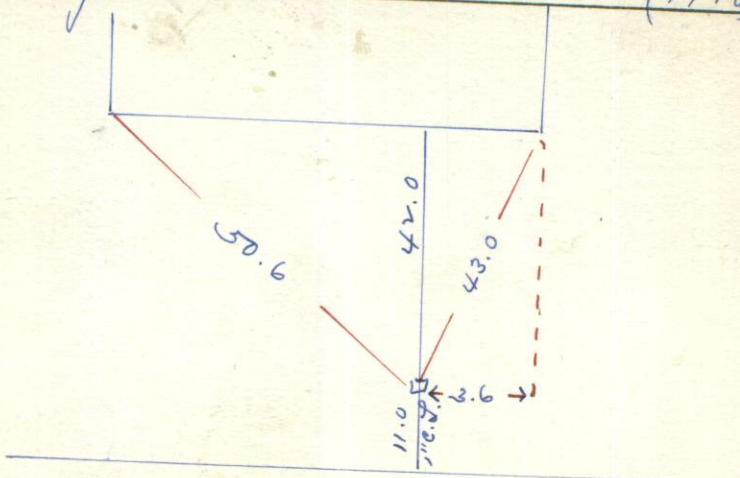

No. 20 Country Cir. STREET | APP. No. 7949

C Akins LOCATION OF SERVICE (1950)

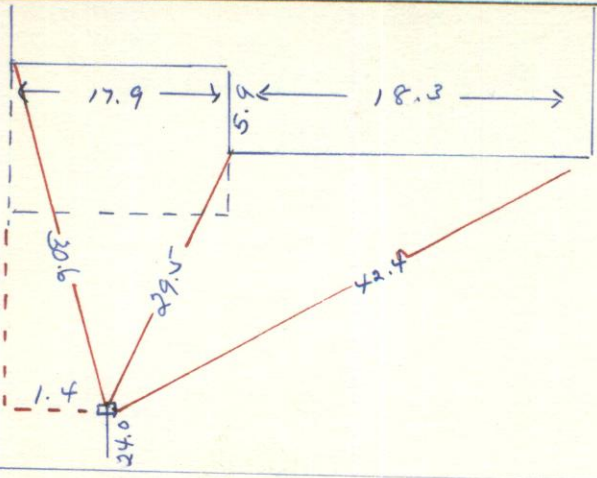

No. 21 Country Dr. STREET | APP. No. 7496

R. Manoogian LOCATION OF SERVICE (1948)

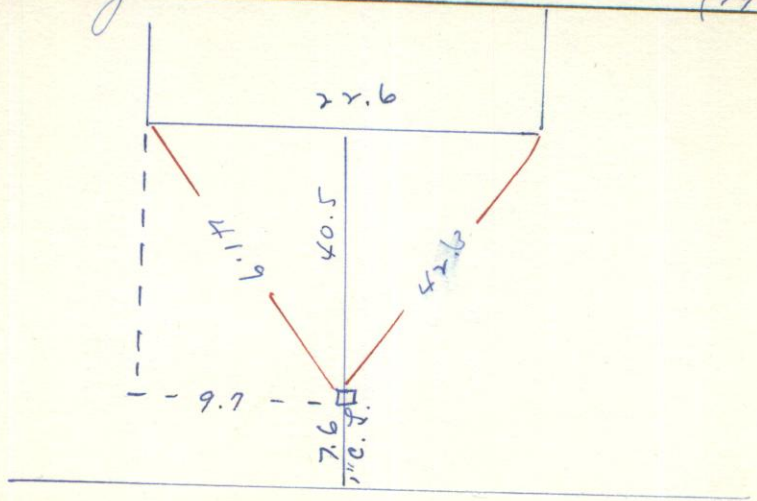

No. 77 Country Club STREET

APP. No. 7930

2 Credit LOCATION OF SERVICE (1950)

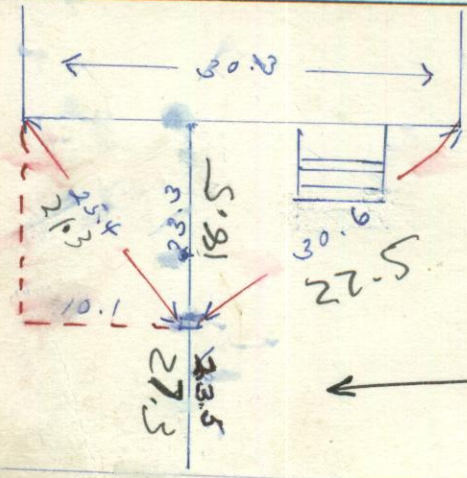

5-19-08 REN.
1" COPPER MAIN TO STOP. EXISTING 3/4 COPPER TO HOUSE.

No. 23 Country Clr. STREET | APP. No. 7497

Clapp LOCATION OF SERVICE (1948)

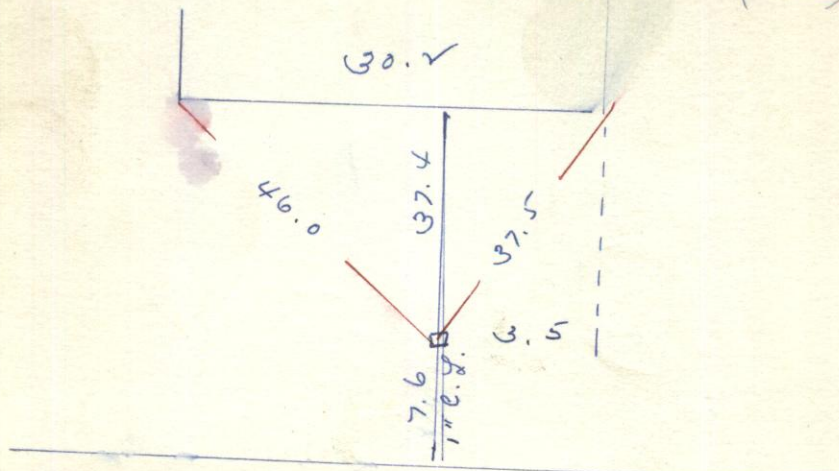

No. 24 County Dr. STREET

APP. No. 7954

F. Monahan LOCATION OF SERVICE (1950)

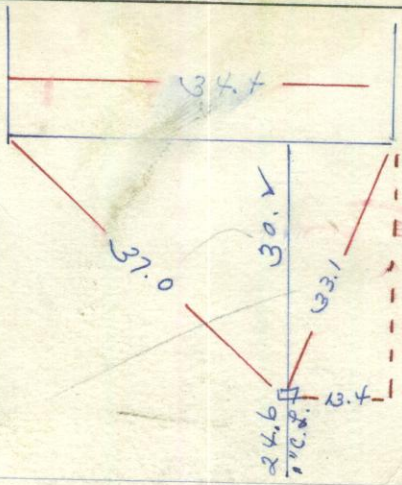

No. 25 Country Drive STREET | APP. No. 10,993

New Service LOCATION OF SERVICE

June 18, 1968

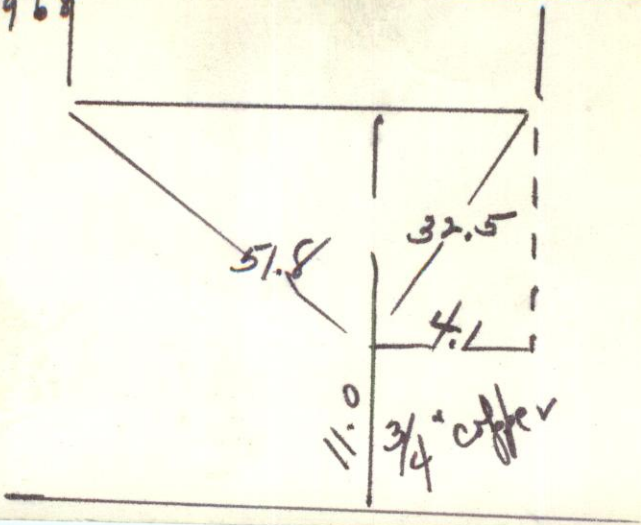

No. 26 Country Club Street | App. No. 7499

LOCATION OF SERVICE 1948

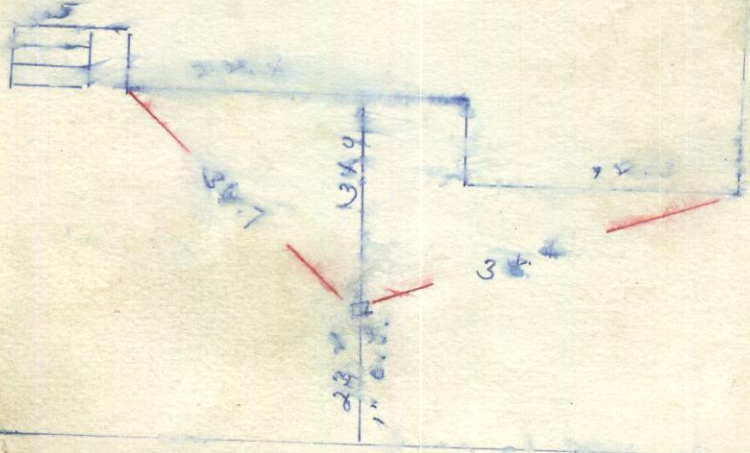

No. 27 Country Cir. STREET | APP. No. 7780

B. Farnham LOCATION OF SERVICE (1949)

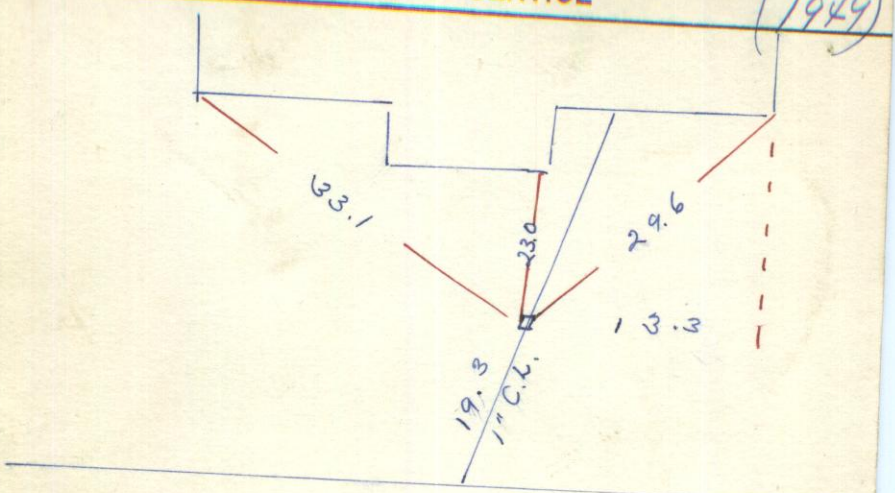

No. 78 COUNTRY DRIVE STREET | APP. No. 7500

New Loc 1970 LOCATION OF SERVICE C. Kelly

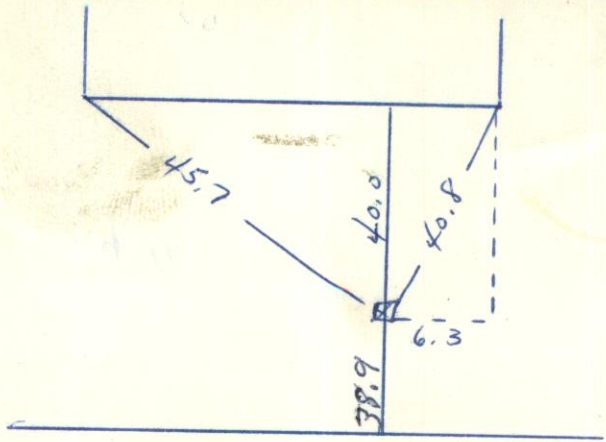

No. 28 Country Klv. STREET | APP. NO. 7500

E. Kelley LOCATION OF SERVICE (1948)

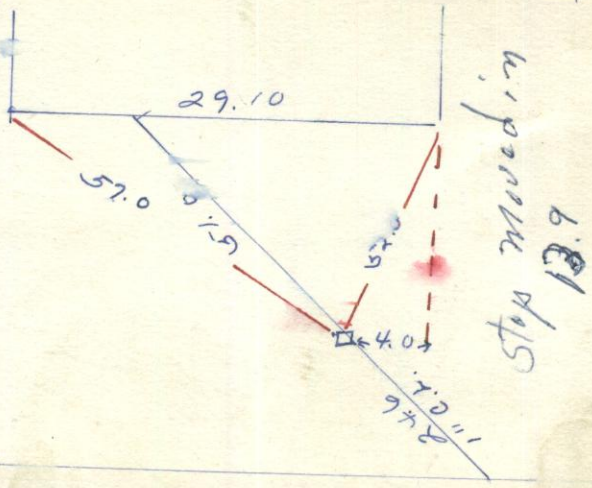

No. Country Dr. cor Cabot STREET | APP. No. 7473

P. Guthrie LOCATION OF SERVICE Apr. (1948)

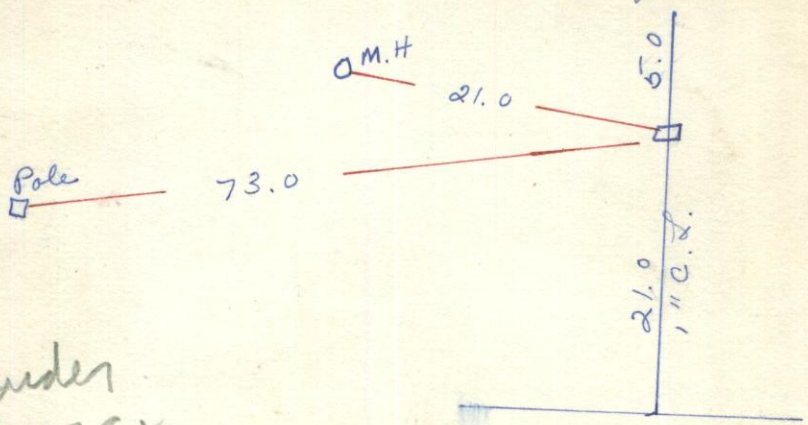

Garden Service

No. 338 Grapevine Rd (Wenham) ~~STREET~~ | APP. No. 9051

New hse - Sept 11, 1961 LOCATION OF SERVICE (IN)

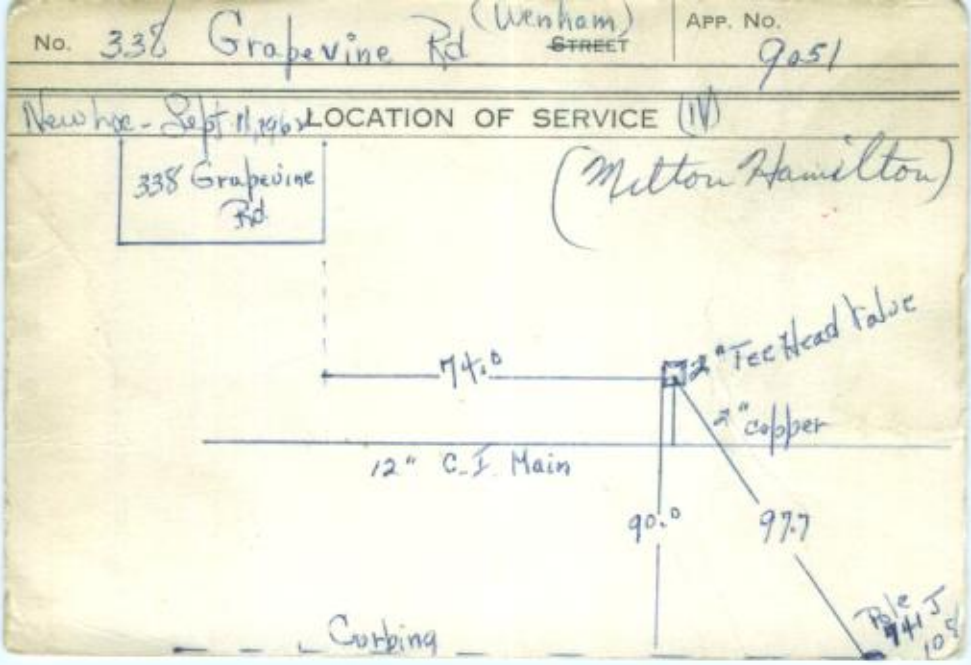

No. 347 Grapevine Rd STREET | APP. No. 7446

1948 LOCATION OF SERVICE

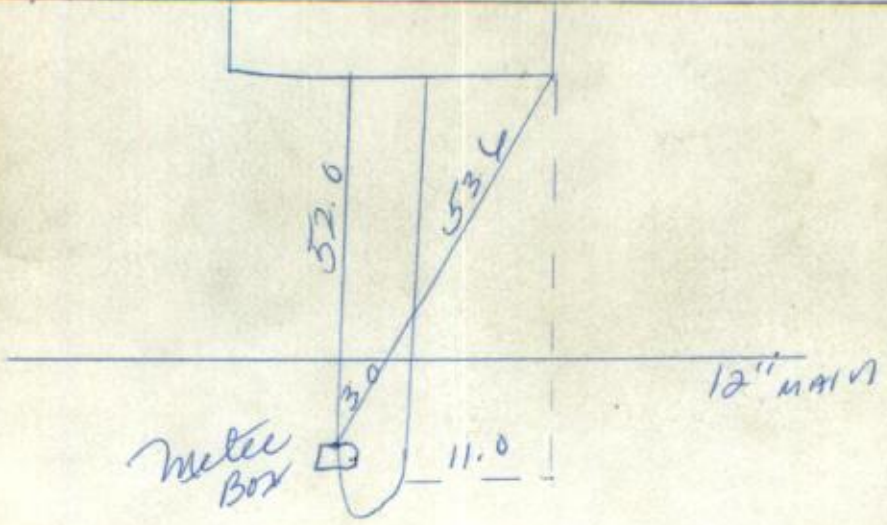

No. 350 Meadowview Road Endicott Estates STREET

APP. No. 8889

D.H.

M. W. Endicott LOCATION OF SERVICE 4/15/54

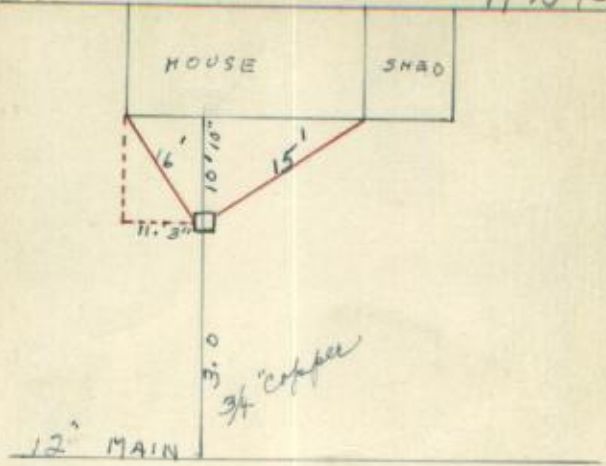

NO. 355 & 359 Grapevine Rd Wenham STREET | APP. No. 10,370

Paul F Zampell

1961

LOCATION OF SERVICE (Supplies Two Houses)

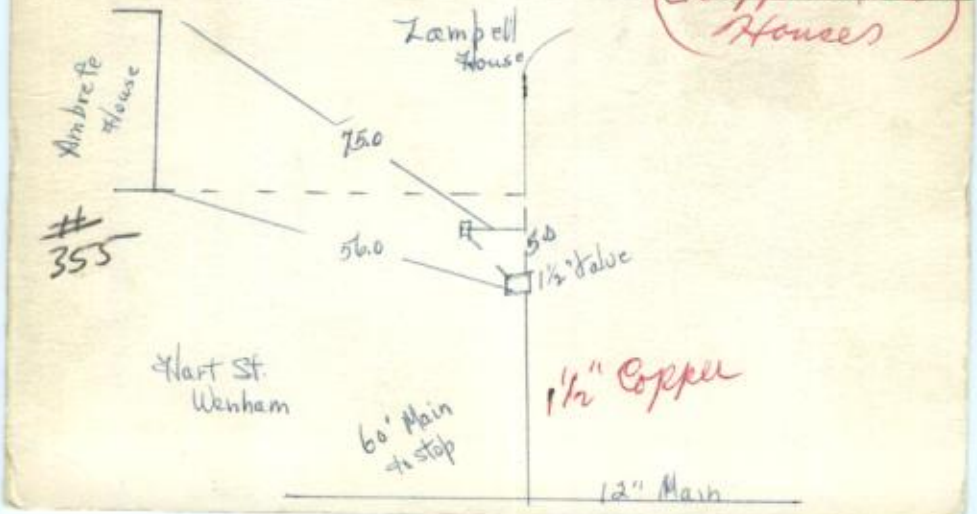

No. 361 Grapevine Rd | STREET | APP. No. 10,964

Inc - Nov. 2, 1967 LOCATION OF SERVICE Donald Gibbons

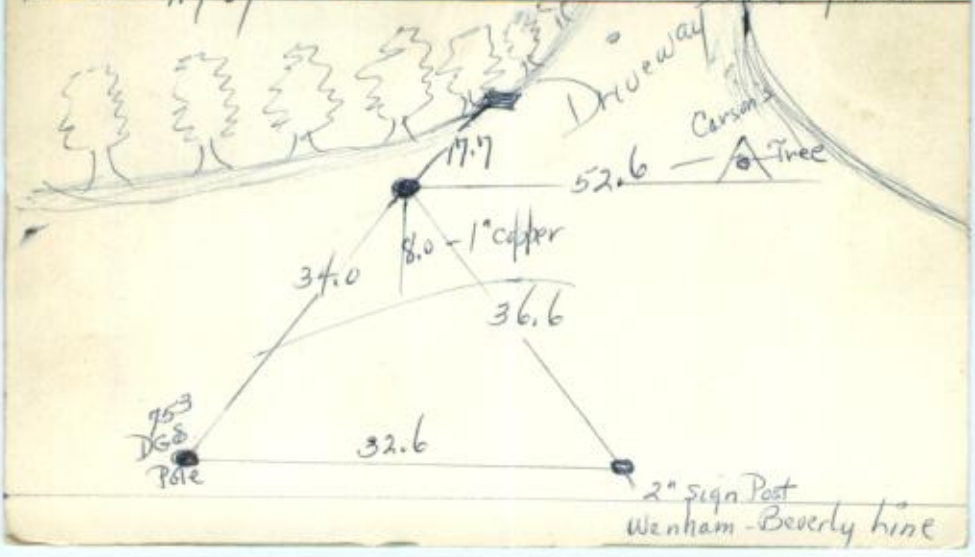

No. GRAPEVINE RD Gordon College STREET | APP. No. 8560

1-23-1953 LOCATION OF SERVICE 6" CICL

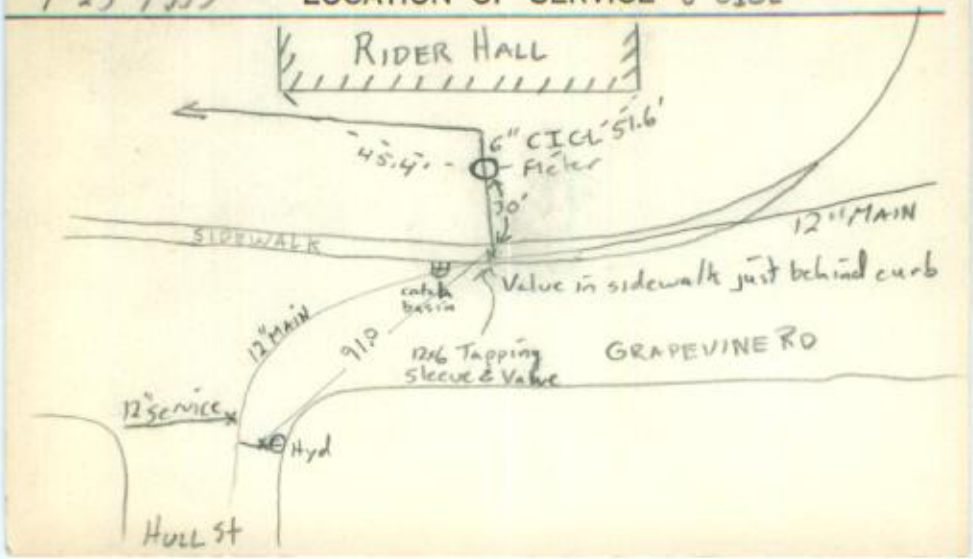

No. Grapevine Rd. STREET APP. No. 5446

New Measures LOCATION OF SERVICE Nightingale

Feb. 5, 1968

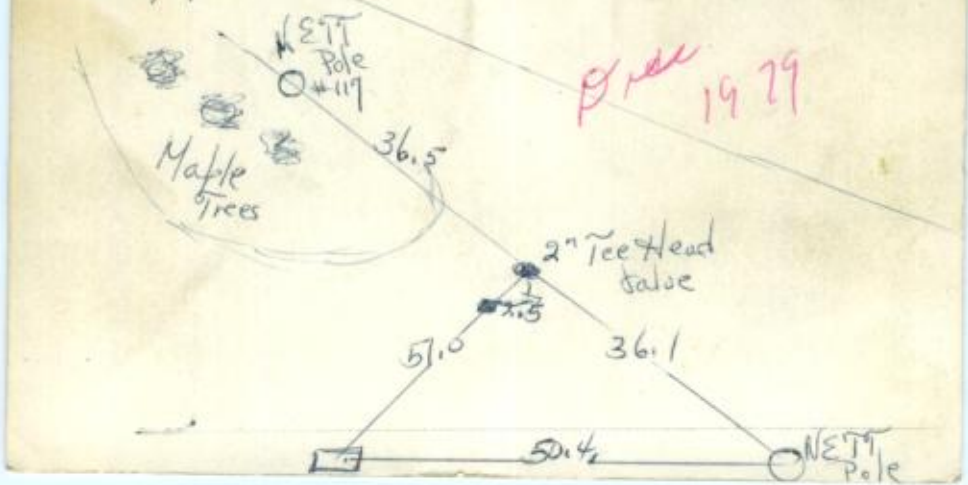

Grant 1979

No. Grapevine Rd Wenha. STREET | APP. NO. 7149

1945 LOCATION OF SERVICE

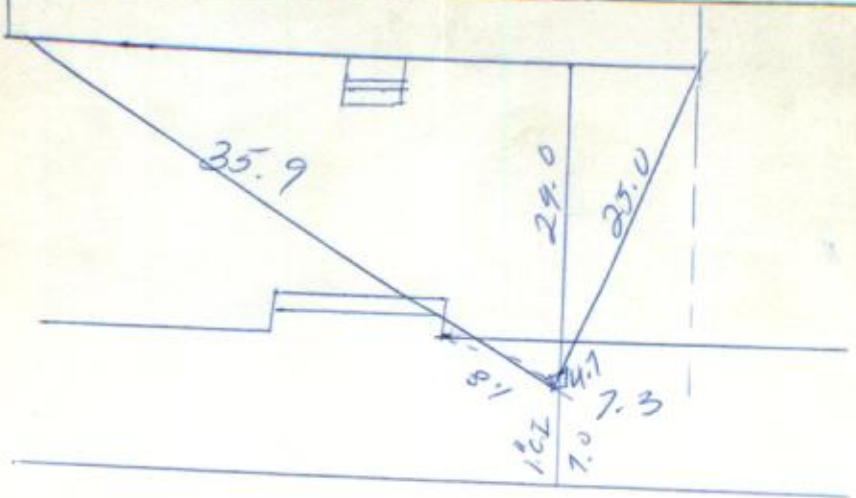

No. Grapevine Rd STREET | APP. NO. 8560

1953 LOCATION OF SERVICE Gordon -

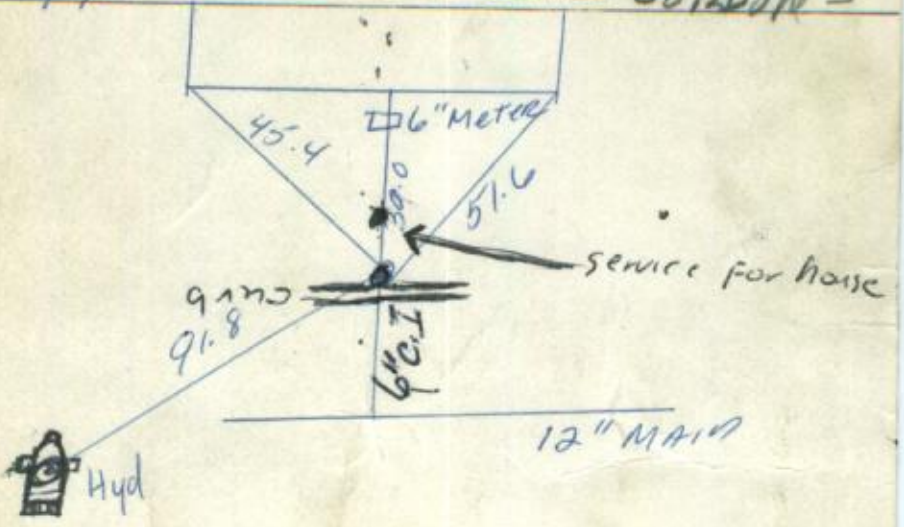

No. Grapevine Road STREET | APP. No. 7203

Patrick J. Harmon LOCATION OF SERVICE July 12, 1946

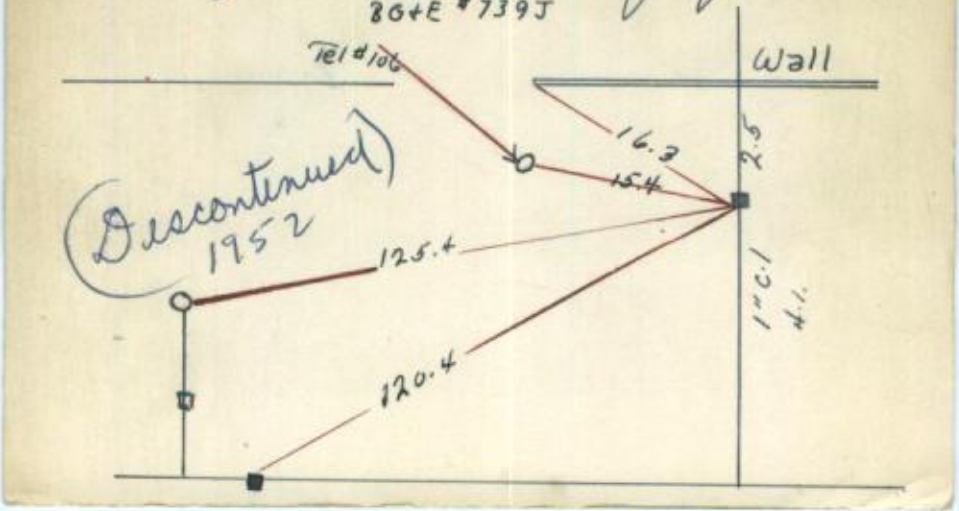

No. Grapevine Rd. STREET | APP. NO. 7375

1947 LOCATION OF SERVICE

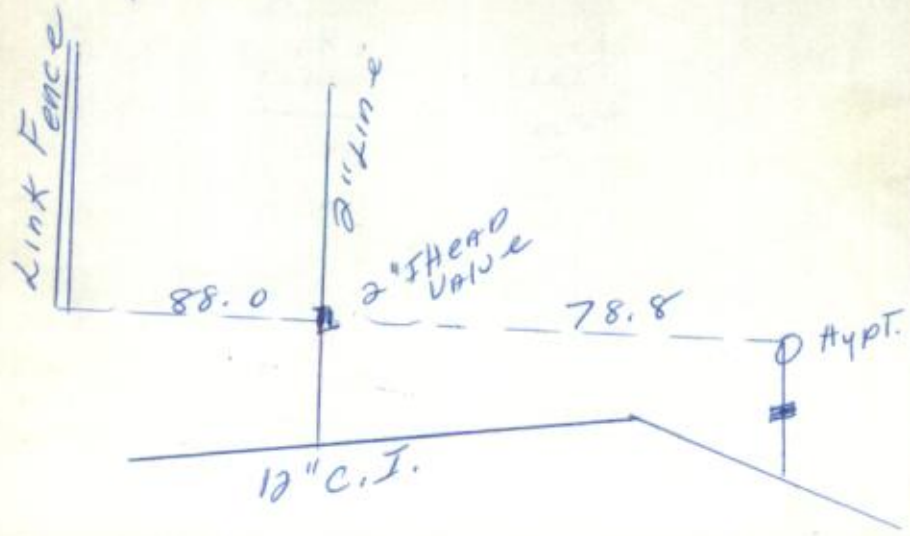

No. Grapevine Road Street | App. No. 7629

1948

LOCATION OF SERVICE

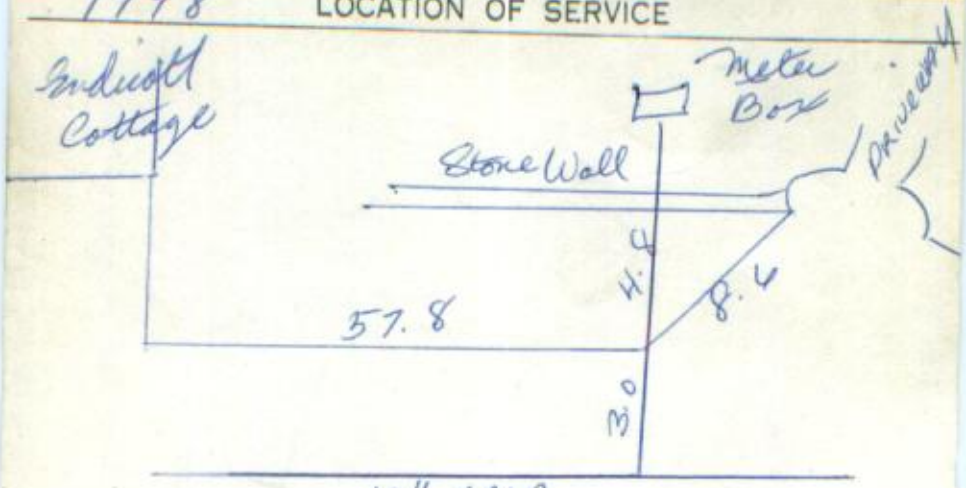

APP. NO.

No. 1 HART ST STREET

BAPTIST CHURCH ADDITON

LOCATION OF SERVICE

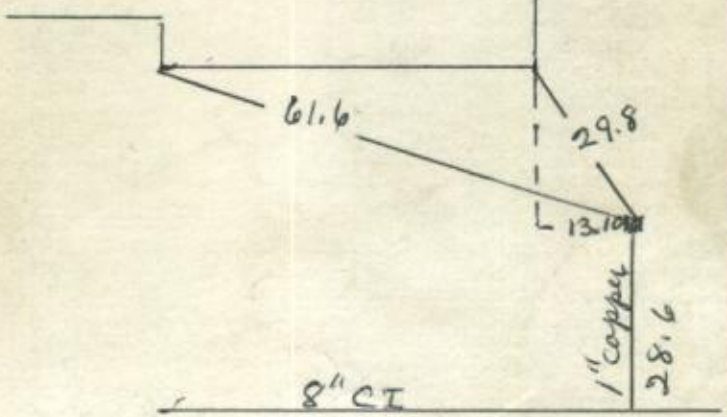

No. 1 Hart STREET APP. No. 866

July 28, 1870

D. H LOCATION OF SERVICE John G. Flint

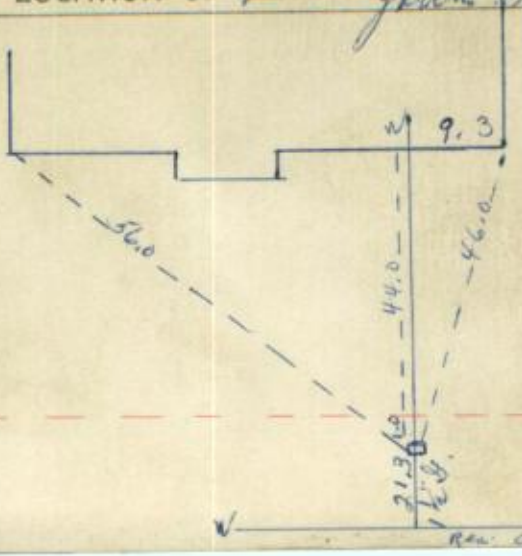

No. 6 Hart STREET APP. No. 3228

March 7, 1898

D.H LOCATION OF SERVICE Mrs. T. Leahey

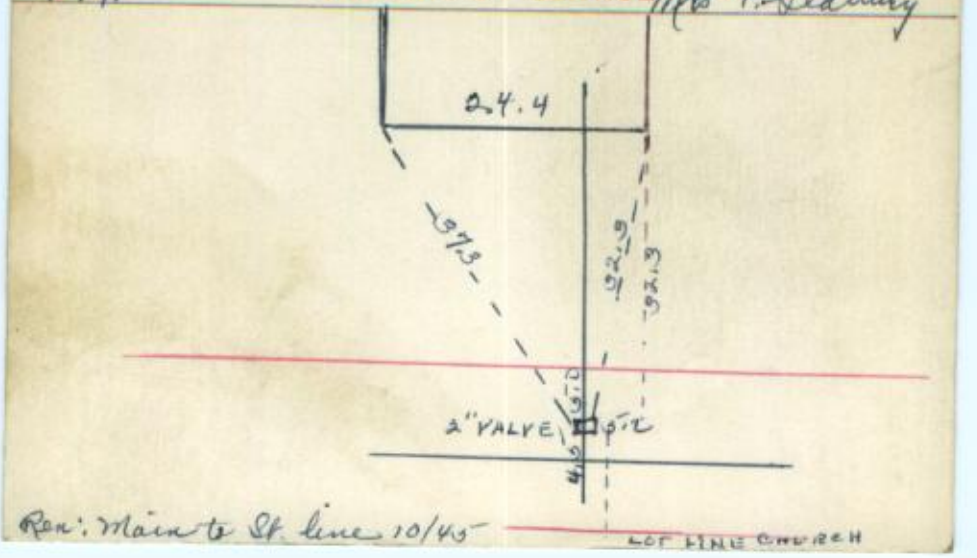

No. 6 Hart STREET APP. No. 3249

J.W.B. June 18, 1878

Stable LOCATION OF SERVICE Mrs. F. Seabury

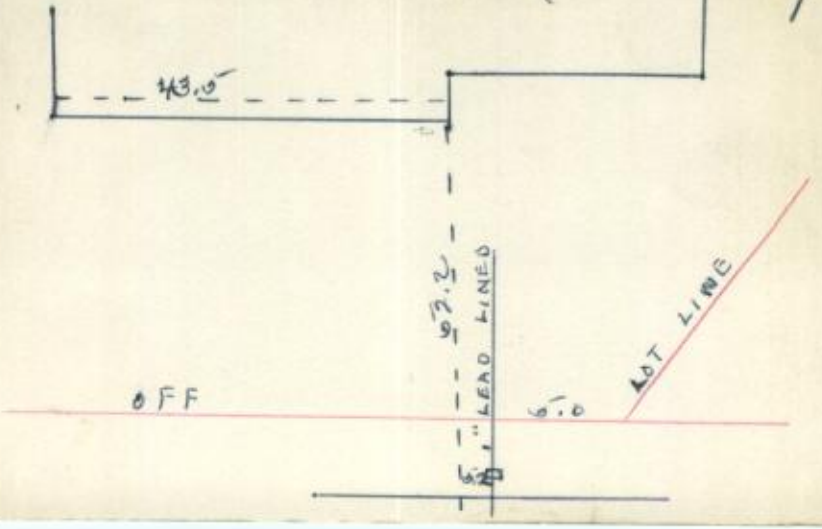

This serv. disc. inside.
Supplied from house.

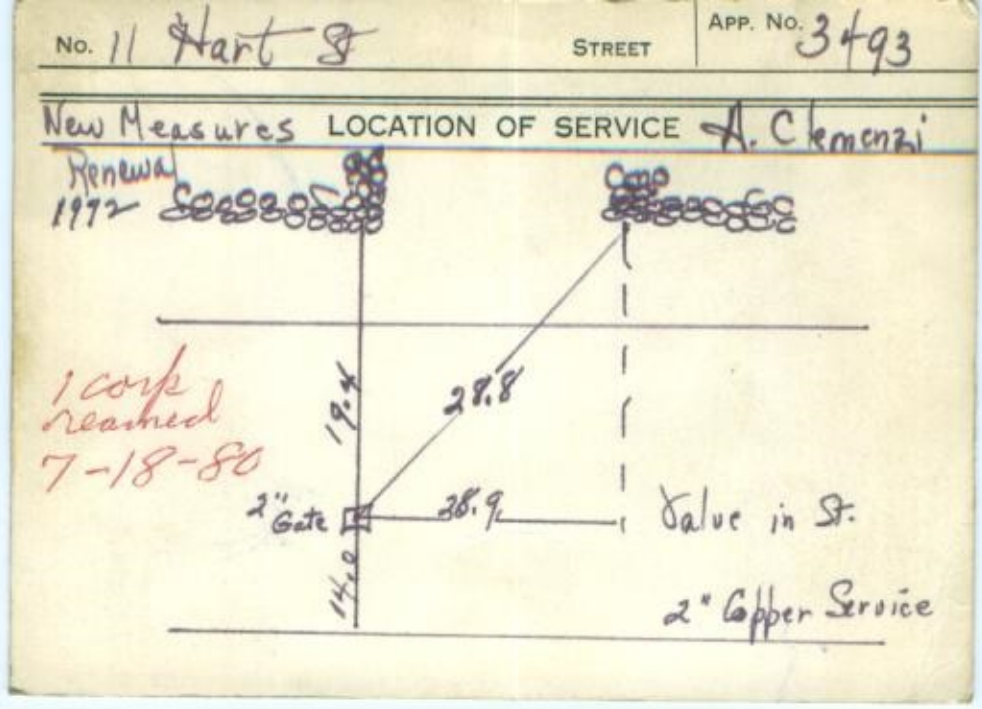

open right wheel valve

No. 11 Hart Street App. No. 3493

J.W.B. July 5 1902

D.H. Portable LOCATION OF SERVICE W.R. Sears Jr

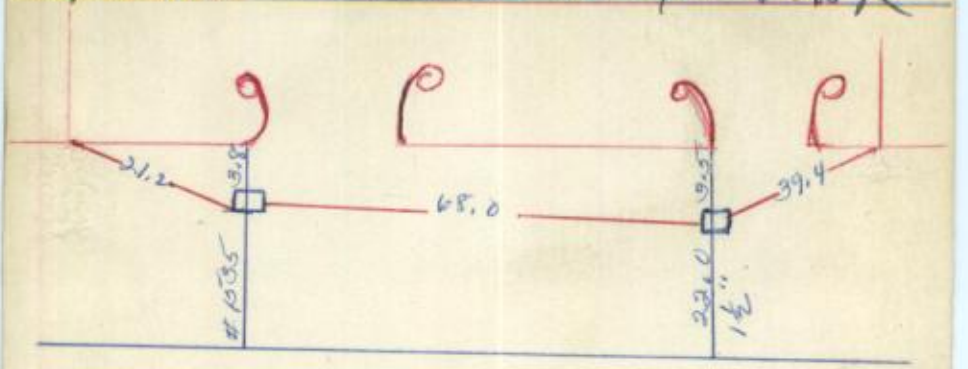

M.R. 1910

A. Clemenzi.

No. 12 Hart STREET APP. No. 1343

C.P. Oct 24, 1894

D.H LOCATION OF SERVICE D. Reardon

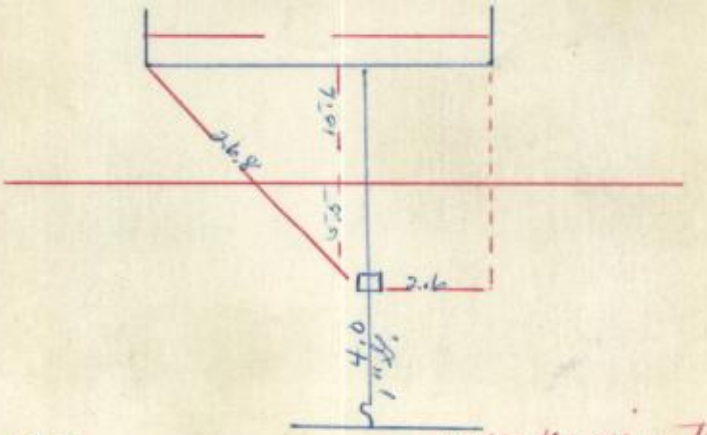

RRN: May 1918
M.L. 1912

12 to 7/8 2 ten main to stop
RRN May 1907

Delia Lyden
12/27/15 2 - Leak on S+W rem. main
stop 4.0 ft 1" C.L.
1 "S+W 6" nipple 1" sleeve

No. 15 Hart STREET APP. No. 1535

August 27. 1879

D. H LOCATION OF SERVICE Wendell Crosby

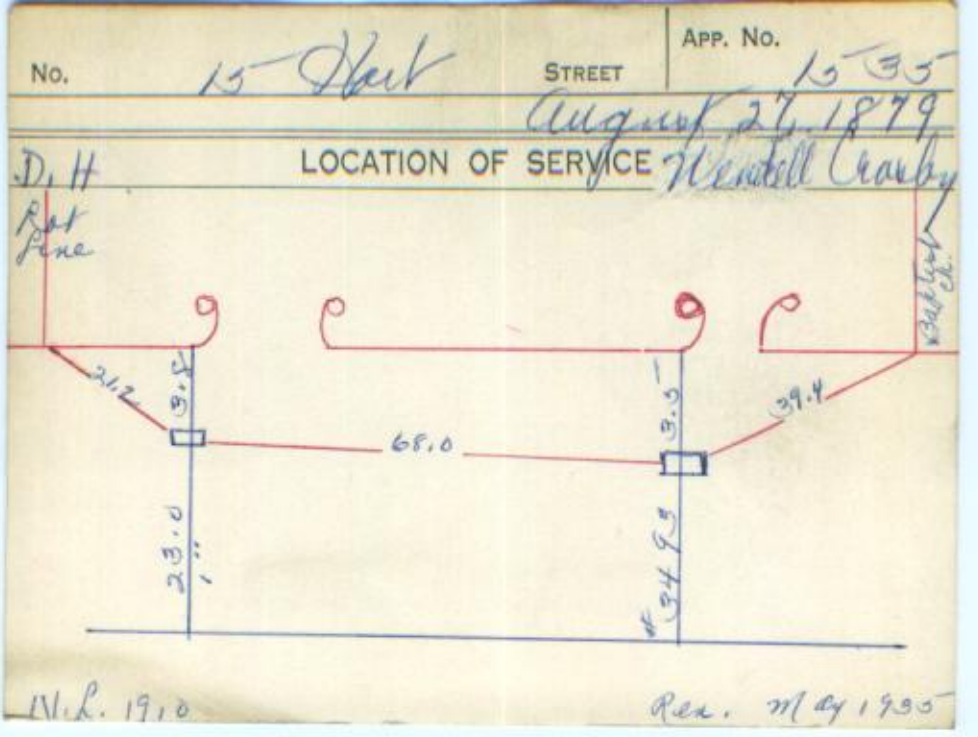

W. L. 1910 Ren. May 1900

S.W. moved in 5.6 ft. Valve & meter moved in 8.0 ft. St. line changed - 8 ft - 1½ gals. pipe put in April 1947

1/6/56
Leak on S & W
1 - close nipple, 1 "sleeve

No. ~~49~~ 25 Hart St STREET | APP. No.

LOCATION OF SERVICE

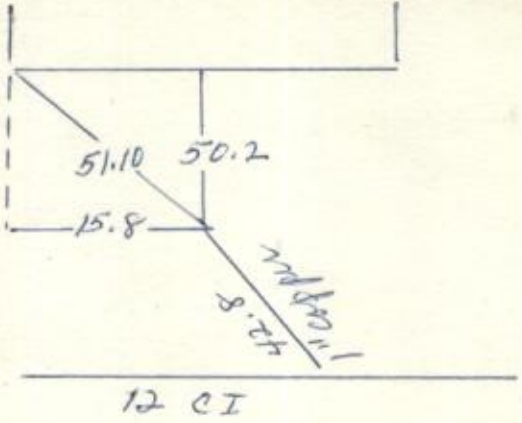

No. 16 Hart STREET APP. NO. 869

Feb. 1960
Renewed 1947

LOCATION OF SERVICE Rust in Lydon

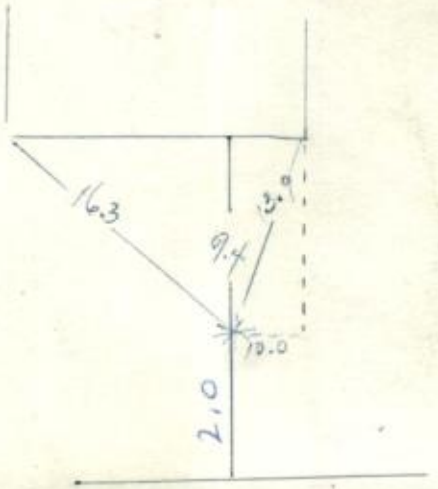

No. Rear 18 Hart STREET APP. No. 6034

J.W.B. May 13, 1926

D.H LOCATION OF SERVICE Austin D. Lydon

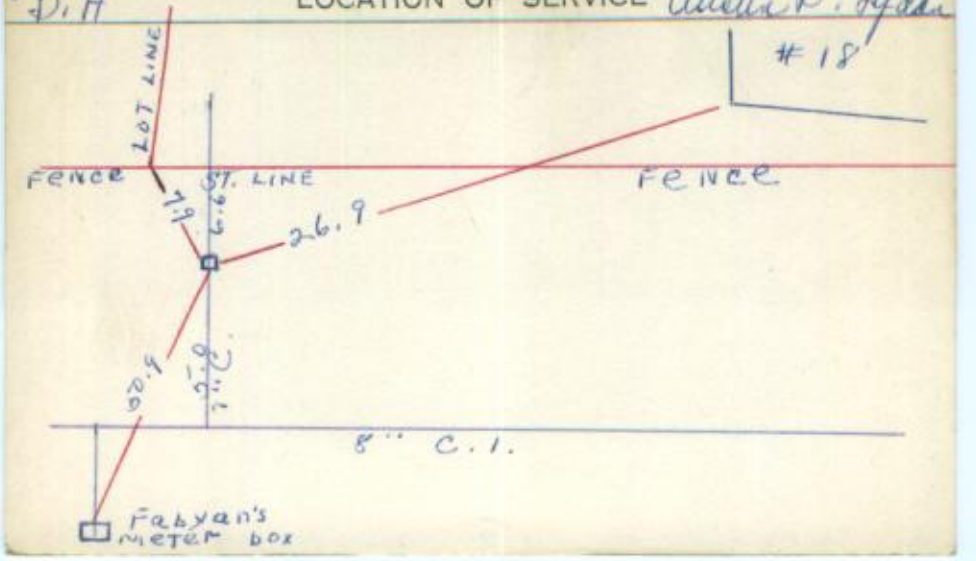

No. 30 Hart St STREET

APP. No. 9190

R.F.D.

Feb. 28, 1956

D.H.

LOCATION OF SERVICE Thomas Connolly

Feb. 28, 1956

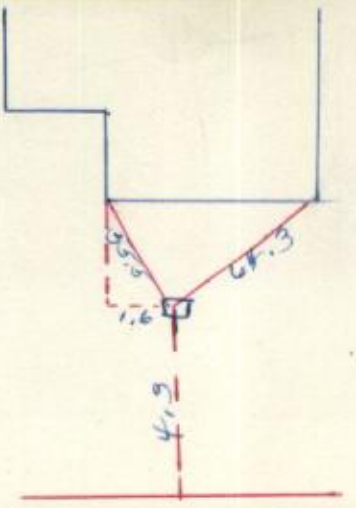

No. 22 Hart | STREET . | APP. No. 6492

J.N.B. April 3 1930

D.H. LOCATION OF SERVICE S. Spindlehyzi

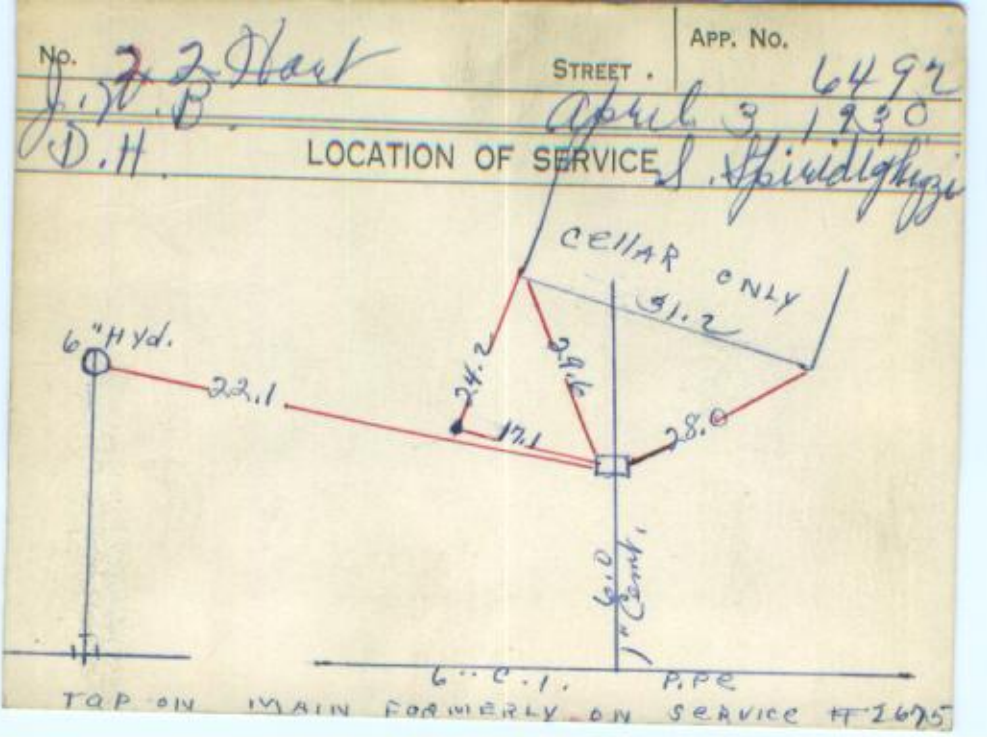

TAP ON MAIN FORMERLY ON SERVICE # 1675

No. 27 Hart St | STREET | APP. No.

LOCATION OF SERVICE

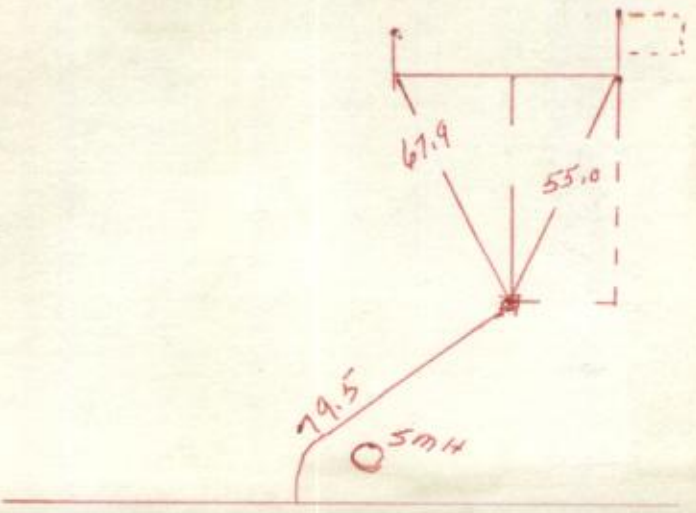

No. 28 Hart Street App. No. 871

August 1, 1878

D.H. LOCATION OF SERVICE Robert C. Hodgkins est

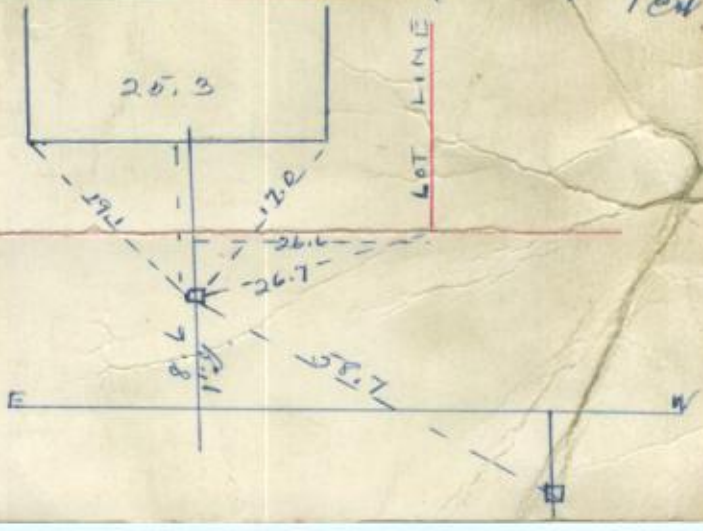

Robert C. Hodgkins Esq.

No. 32 Hart STREET APP. No. 1681

C.P. August 22, 1854

D.H LOCATION OF SERVICE G. J. Cranwell

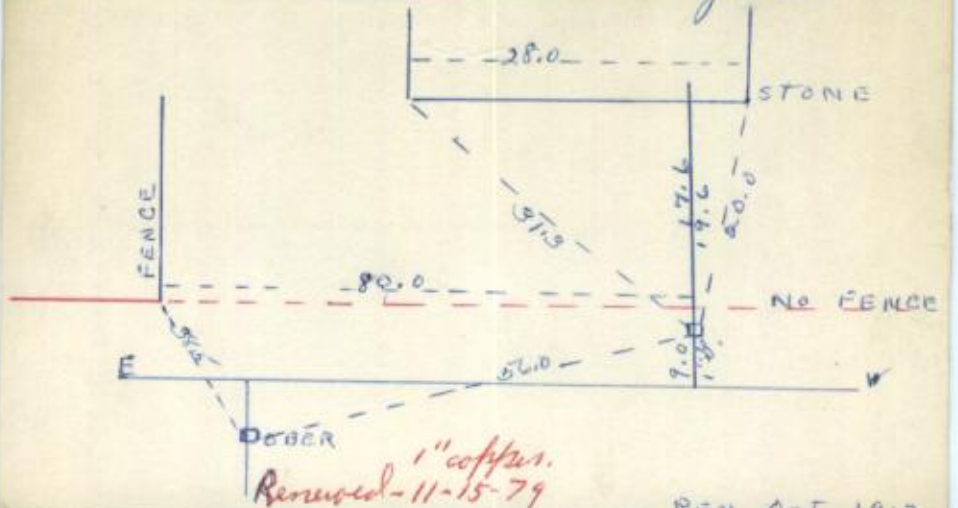

REN OCT. 1912

John F. Gates
9/15/54 - Leakey D & W Cut thread
new D & W - 1-1" sleeve

No. 33 HART ST STREET | APP. No. 11725

LOCATION OF SERVICE

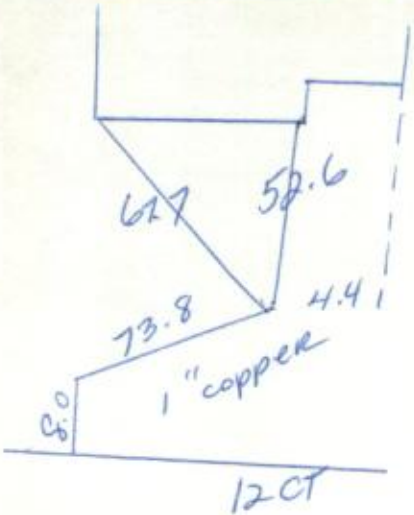

No. 33 Hart STREET APP. No. 842

August 1, 1870

D. H LOCATION OF SERVICE Mrs. F. J Chastney

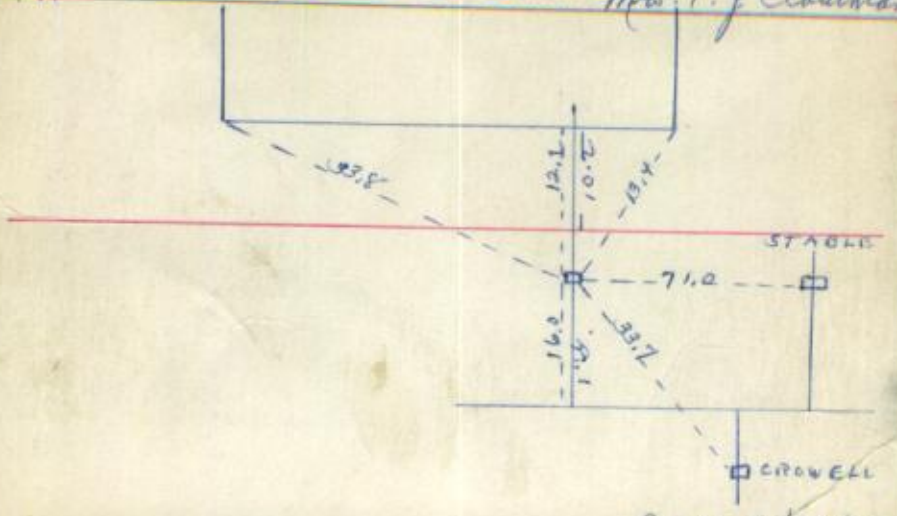

RENI 6/30/47

6/5/89 - cracked
1/20/90 leak
2/22/90 - Cracked good

1-25-90 - LEAK ON OUTSIDE

No. 34 Hart STREET APP. No. 4821

F.W.B. Aug 19, 1911

D.H. LOCATION OF SERVICE Richard McElhinney

(Renewal 1969)

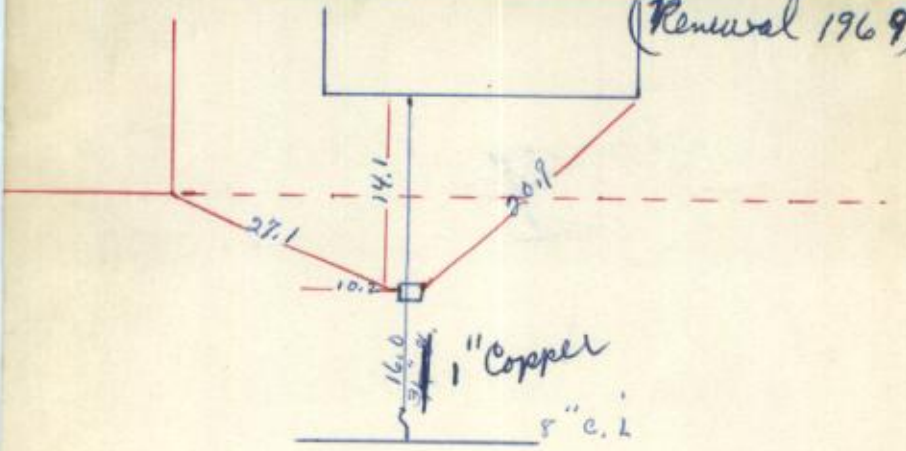

1/6/48 - Probed - O.K.

No. 35 Hart St | Street | App. No. 4503

Location Of Service

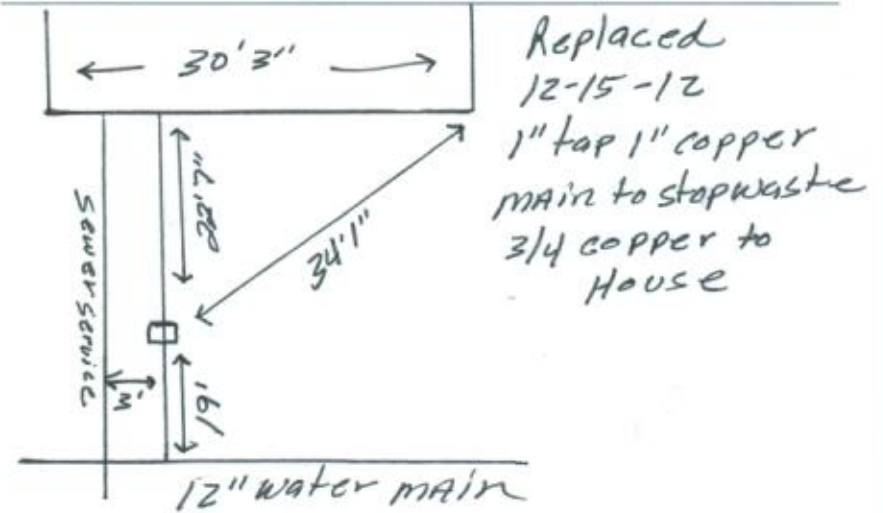

No. 45 Hart St | STREET | APP. NO. 873

LOCATION OF SERVICE

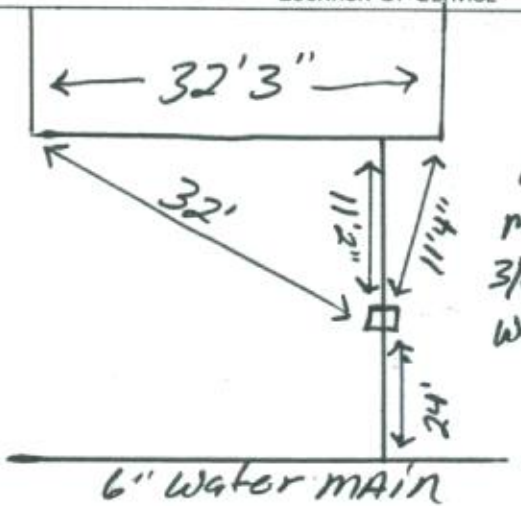

Replaced
7-21-10
1" tap 1" copper
main to stop
3/4 copper stop
waste to House

No. 48 Hart STREET APP. No. 874

Aug 2 1876

P.H LOCATION OF SERVICE A. H. Dodge

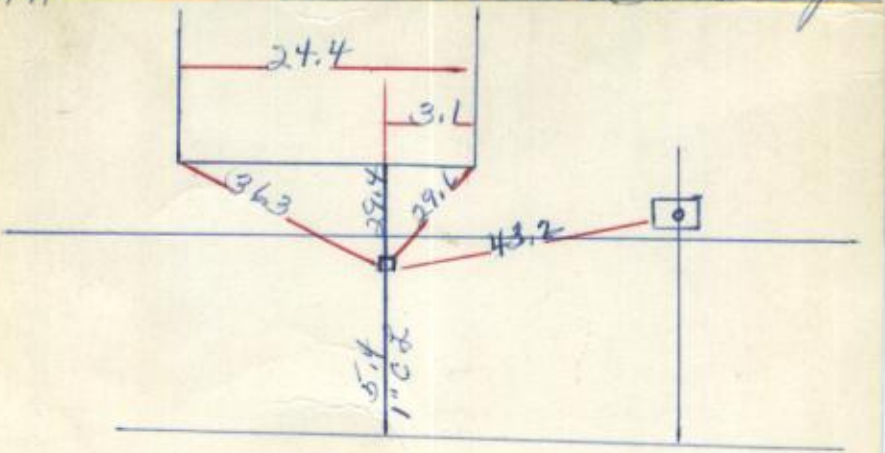

N.L. 1921

7/8/42 - Product - O.K.

No. 48 Hart | STREET | APP. No. 3430-B

J.W.B. | Dec 16, 1940

D.H | LOCATION OF SERVICE N. Hannable

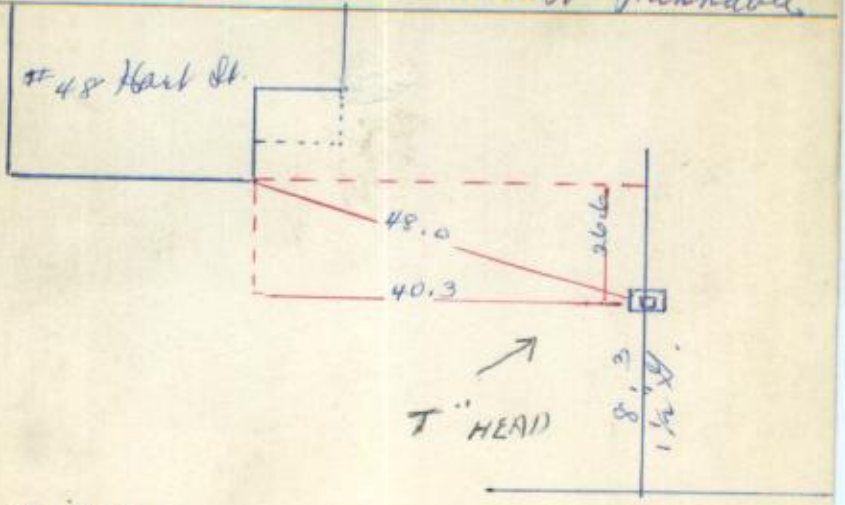

Rev: April 1915

N.L. 1916

No. 49 Hart STREET APP. No. 1602

C.P. June 22 1881

D.H LOCATION OF SERVICE D. Thos. Stanton 21

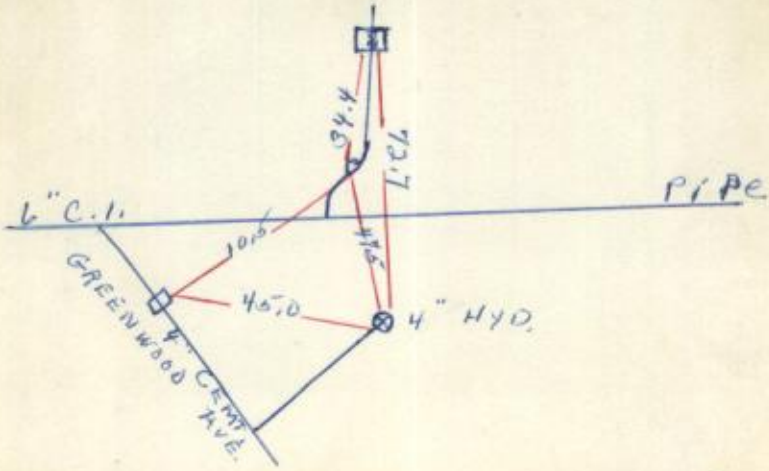

NL-1927 Rev. 1926

No. 53 Hart | STREET | APP. No. 6654

J.W.B. July 18, 1932

D. 14 LOCATION OF SERVICE Wm. A. Dufer Jr.

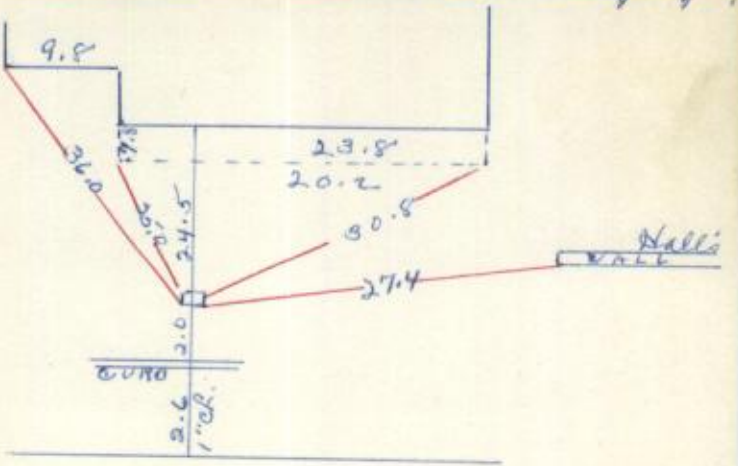

3/30/42 - Washed - O.K.

No. 84 East STREET | APP. No. 875

Robert Williams

N. Y. 1959 LOCATION OF SERVICE 1870

Ren 1914

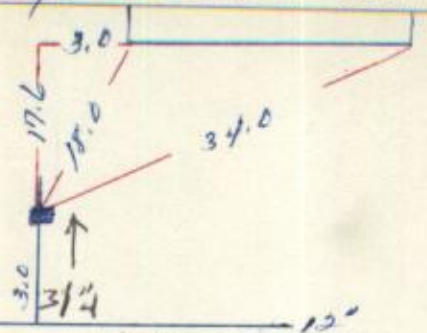

Years 1" corporation
2002 Replaced 3/4 Copper main
To Property Line

No. 58 Hart St STREET | APP. No. 5481

New Service - Aug 28, 1968 LOCATION OF SERVICE Raymond C McGuire

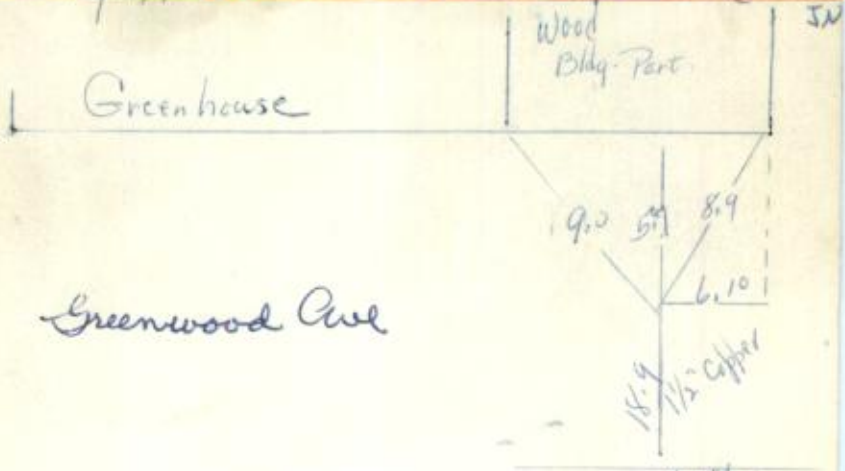

No. 58 Hart	STREET	APP. No.

LOCATION OF SERVICE

New Measures

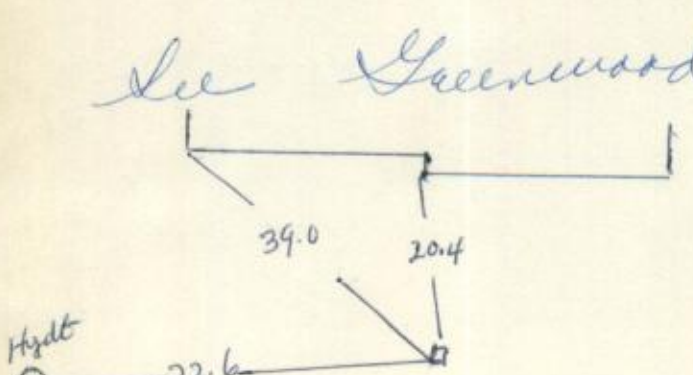

No. Rear 58 Hart STREET | APP. NO.

LOCATION OF SERVICE

See Greenwood Ave.

No. 62 HART ST STREET | APP. NO. 3146

JWB JUNE 14 1897

DH

LOCATION OF SERVICE BARRETT WENDELL

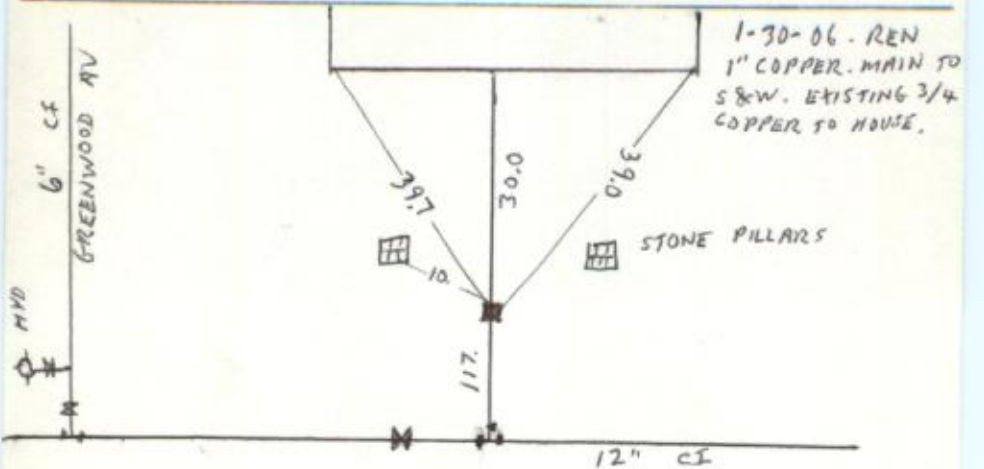

No. 62 Hart STREET APP. No. 3146

J.W.B. June 14, 1897.

D.H LOCATION OF SERVICE Barrett Kendall

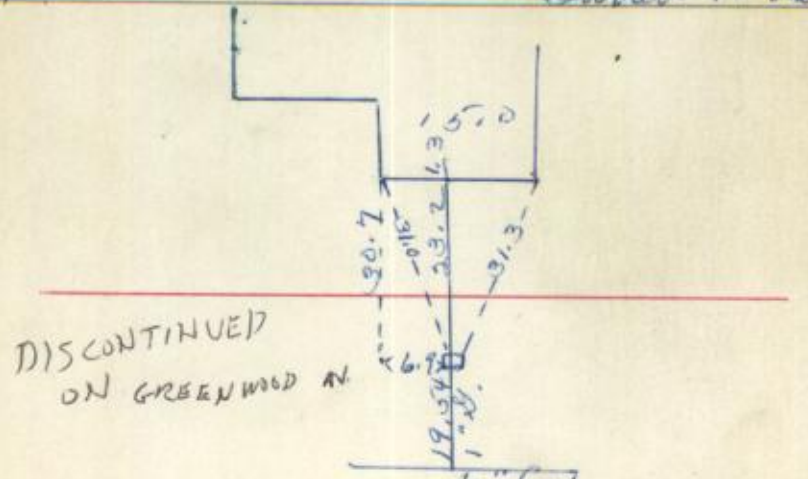

Ren. July 1912

No. 66 Hart STREET APP. No. 3266

J.W.B Sept. 13. 1898

D.H LOCATION OF SERVICE Halifax Garden Co

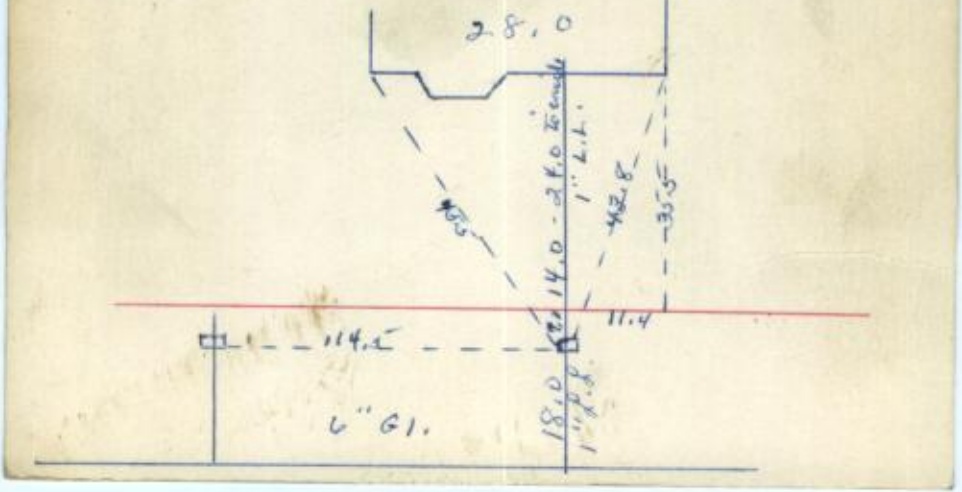

No. 73 · Hart STREET APP. No. 7166

A. N. R. Dec 13 1943

D. H LOCATION OF SERVICE Halifax Garden Co.

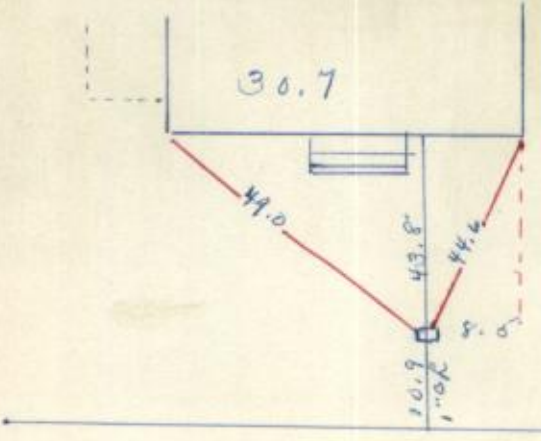

No. 79 Hart STREET APP. No. 12576

1988 LOCATION OF SERVICE

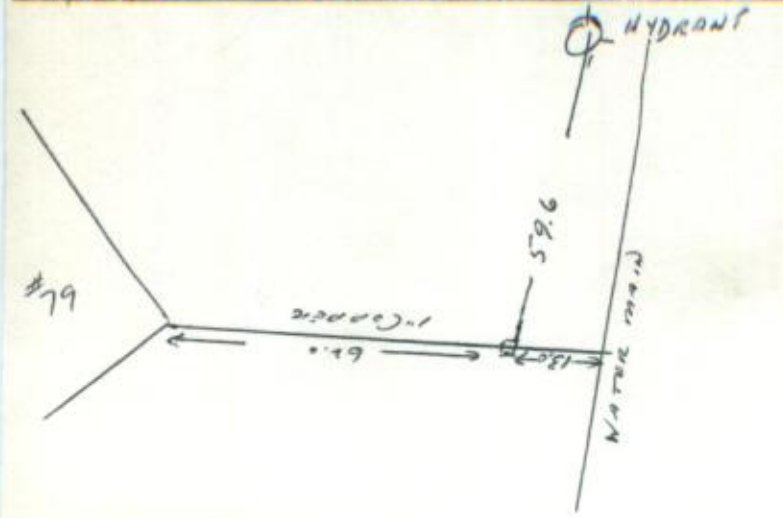

No. 81 HART STREET | APP. NO. 12502

1-88 LOCATION OF SERVICE

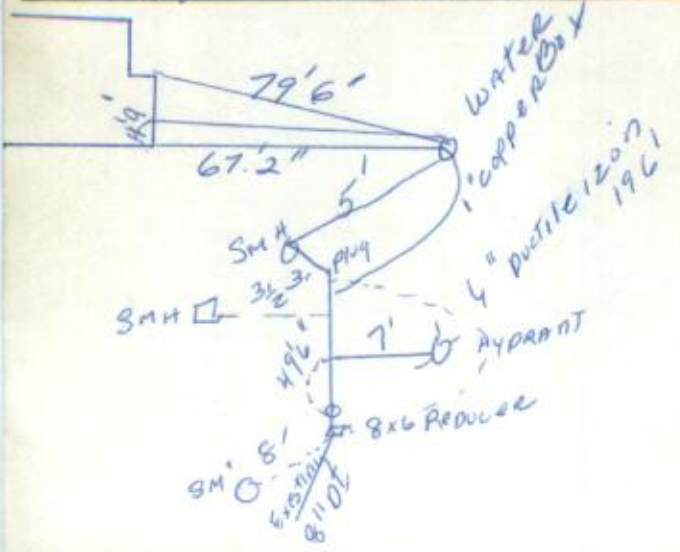

No. 85 Hart STREET APP. No. 2958

Oct. 28, 1895

D. H LOCATION OF SERVICE John A. Wilson

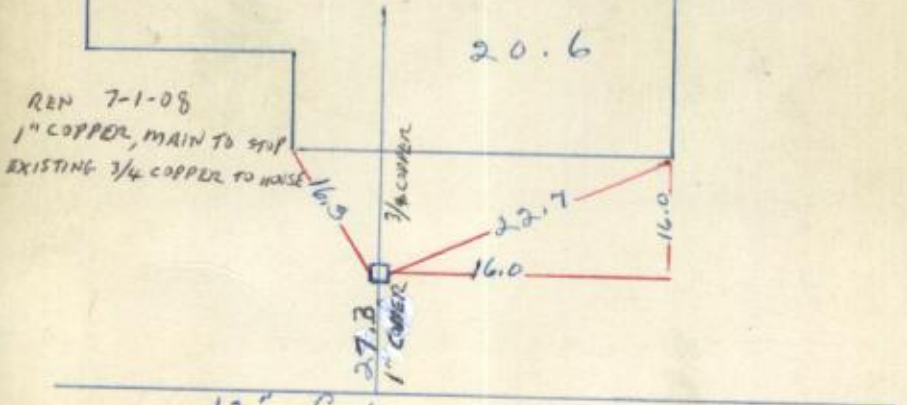

REN 33 N. L. 96

3/3/47 - Probed - OK

No. 86 Hart STREET | APP. No. 876

August 2, 1870.

D.H LOCATION OF SERVICE L. W. Robbins

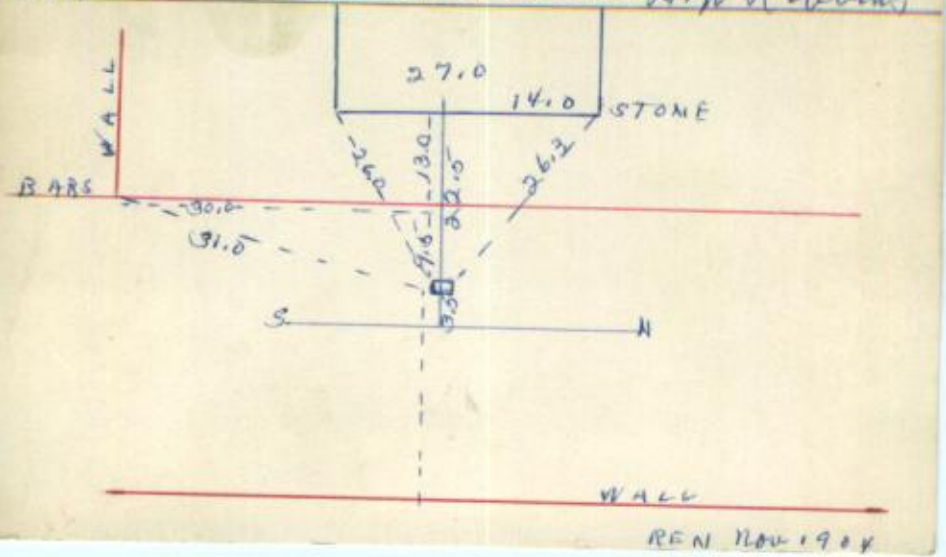

REN Nov. 1904

6/46 - Probed - OK

No. 91 Hart STREET APP. No. 877

Aug 2, 1878

D, 1H LOCATION OF SERVICE Living Garden

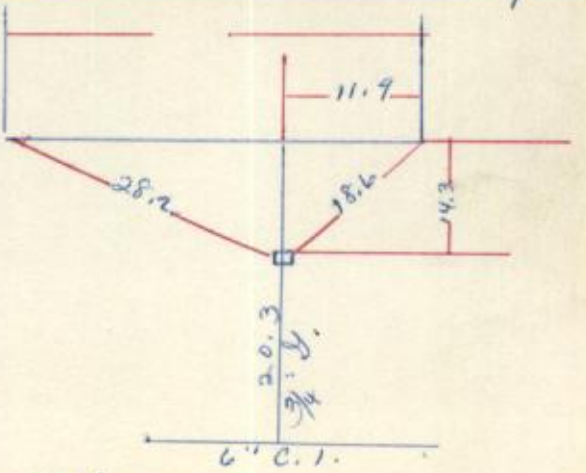

Red: to S & W July 1918 N.L. 1919

Probed 10/31/39
4/2/42 - Probed - Fair

No. 93 Hart STREET APP. No. 6820

G.W.B.

D.H. LOCATION OF SERVICE Wm. J. Harvey

Sept 30, 1937

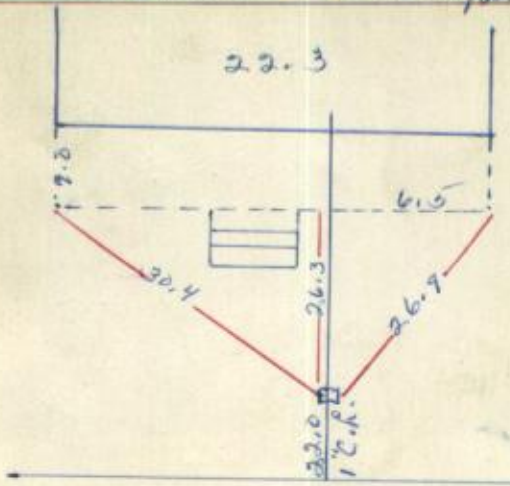

Robert M. Young et ux

No. 94 Hart STREET APP. No. 2860

C.P. Aug. 23, 1886

D.H LOCATION OF SERVICE Wm. P. Brooks

(Renewal 1968)

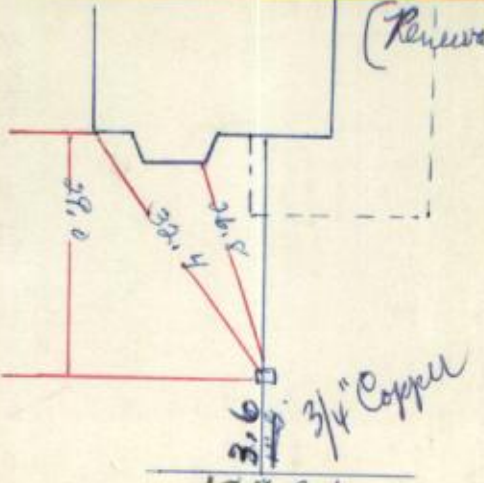

NL. 1919

Charles Milnes
Sealed - 5/18/38

No. 97 Hart STREET APP. No. 8418

Apr. 9, 1952

D.H. LOCATION OF SERVICE L.M. Lister

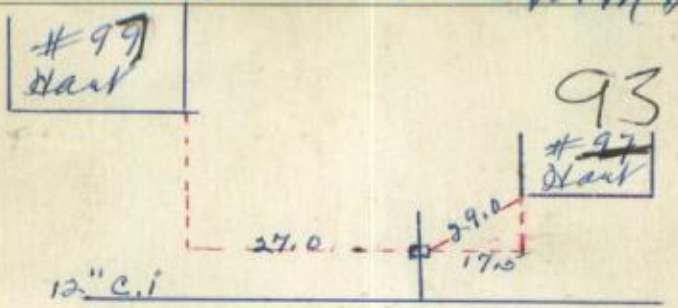

No. 100 Hart STREET APP. NO. 878

N. Hoc - March 23, 1965 LOCATION OF SERVICE Gluckert

Ren. 1915
Probed 1943 - OK.

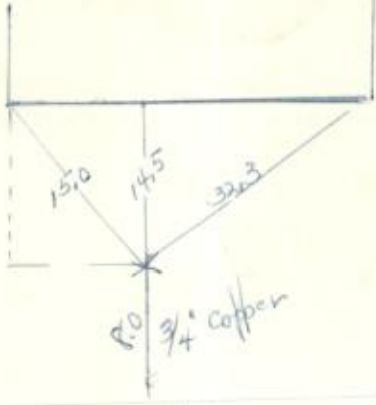

No. 101 Hart STREET APP. No. 2116

C.P. June 6, 1887

D.H LOCATION OF SERVICE Thos. W. Hannahs

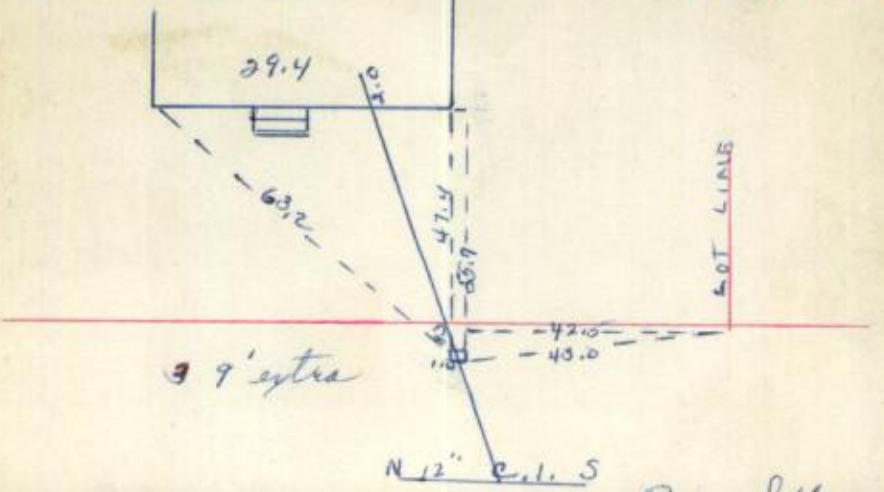

Rec: Sept 1918

NEW-HOUSE

No. 11 10A2 HART — STREET | APP. No.

LOCATION OF SERVICE

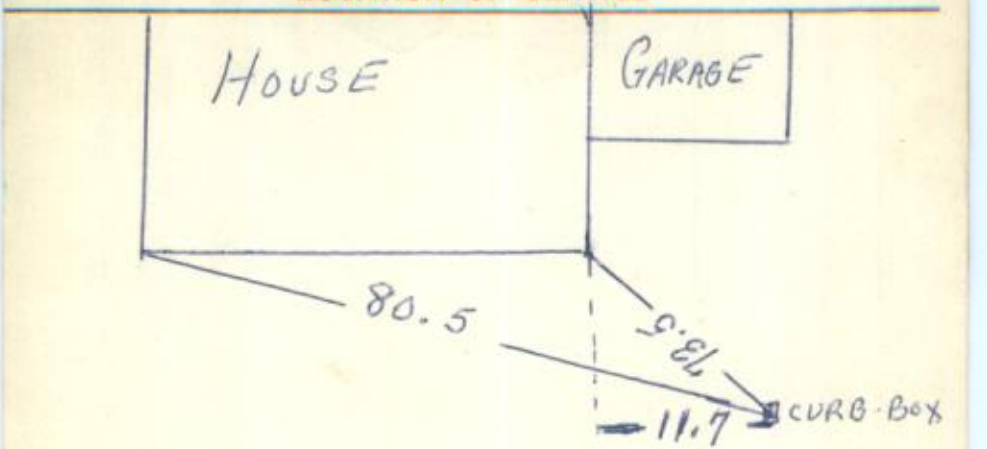

No. #103 Hart St. STREET | APP. NO.

Card up Dated 4-26-06

LOCATION OF SERVICE

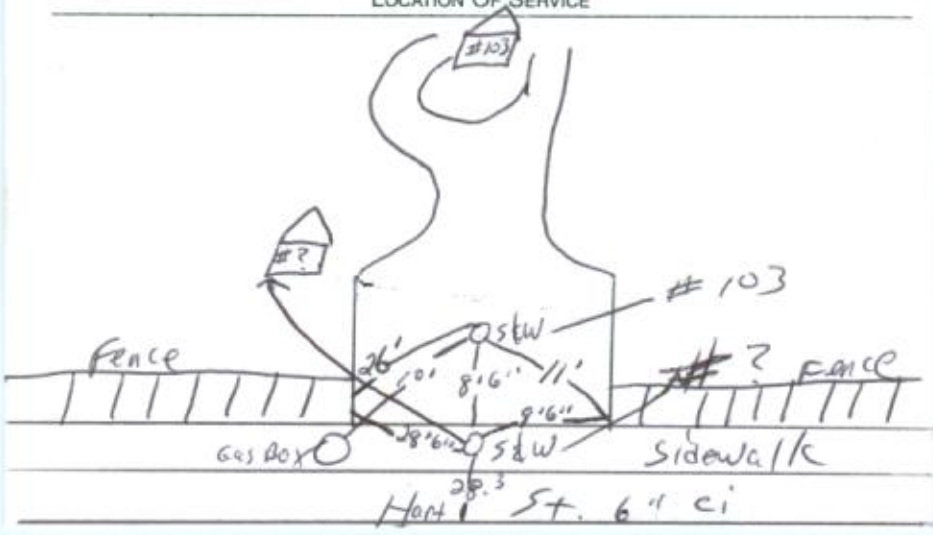

No. 103 Hart STREET APP. No. 879

August 6, 1870.

D.H. LOCATION OF SERVICE B. Williams Hse

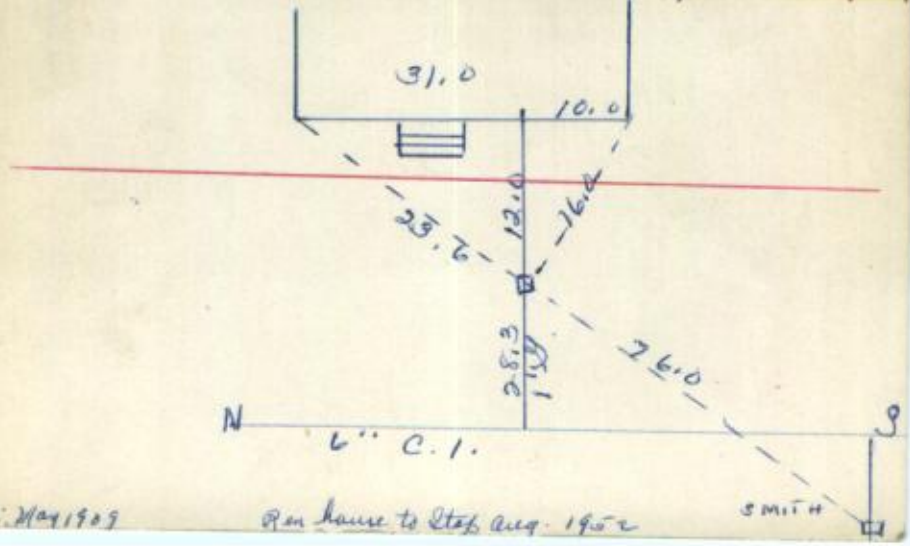

Ren: May 1909 Ren house to Stop Aug 1952

William T. Day Jr.

8/29/52 - probed good"
Ren: dah 3/4 tubing

No. 108 Hart St. STREET APP. NO. 7790

LOCATION OF SERVICE

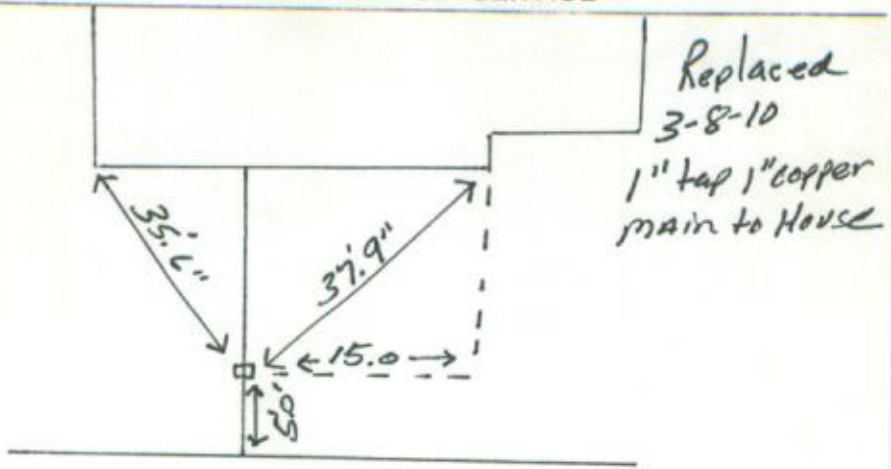

No. 110 Hart STREET APP. No. 7789

Sept 16, 1949

LOCATION OF SERVICE Wm. Day

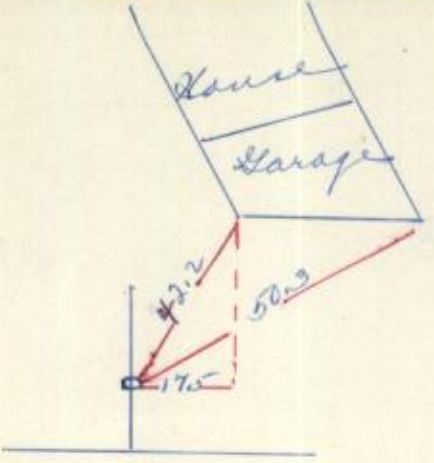

No. 112 Hart STREET APP. No. 7675

G.H.R. Dec 7, 1948

D.H LOCATION OF SERVICE Thos. Spiridigliozi

2-26-09
Service
Renewal

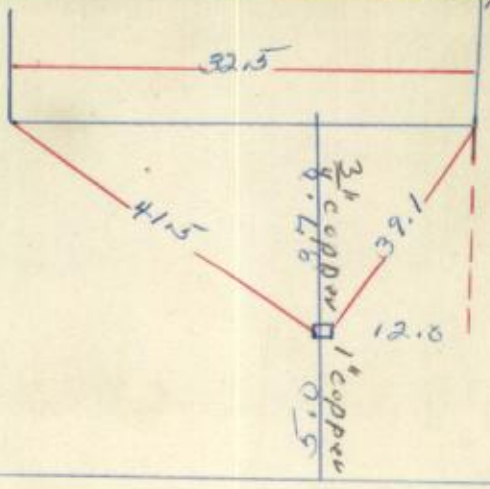

No. 114 Hart STREET APP. No. 8277

May 19, 1951

D.H LOCATION OF SERVICE Ralph Lawler

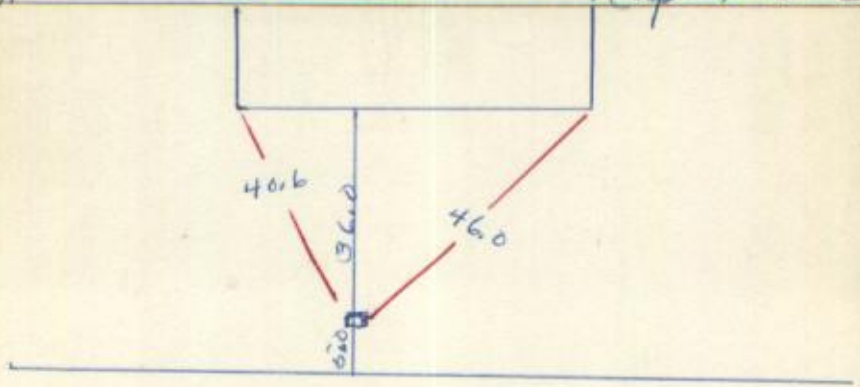

No. 117 Hart STREET APP. No. 881

Aug 2 1870

D.H. LOCATION OF SERVICE B. Pearlon Hse

(Renewal 1968)

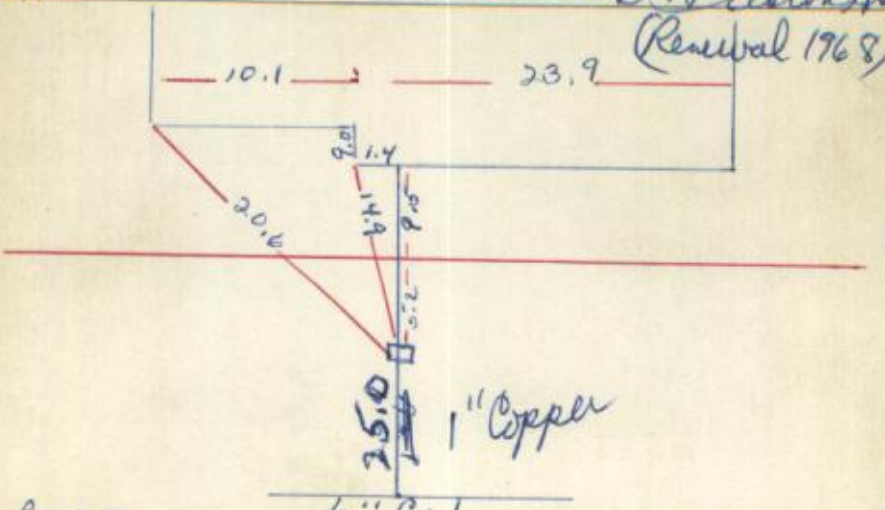

N.L. 19.8

Ren Nov 1911

C. H. Winslow
4/13/50 Packed O.K.

No. 120 Hart STREET APP. No. 1714

C.P. May 1883

Farm House Stable LOCATION OF SERVICE S.R. Rogers Jr

new loc.

N.L 1912 Rev M 65 May 1933

No. 122 Hart STREET APP. No. 5927

Daniel Coughlin

M. L 1958 LOCATION OF SERVICE 1925

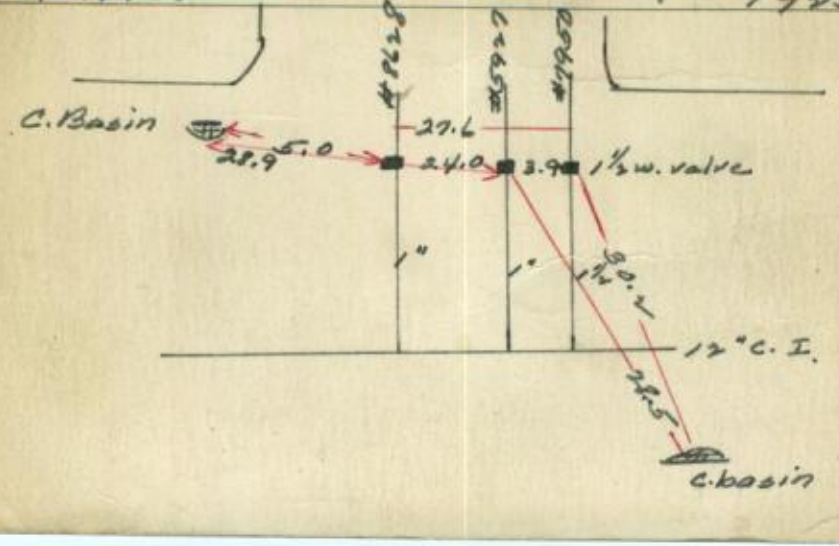

No. 125 Hart STREET | APP. No. 882

1870

N. L. 1958 LOCATION OF SERVICE Ren 1920

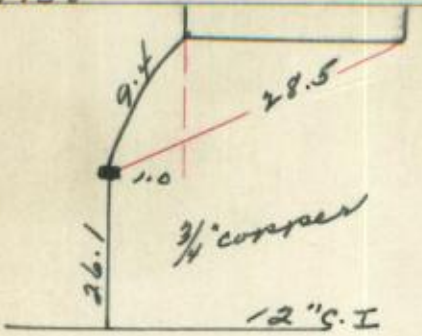

Moving House

No. 127 Hart STREET | APP. No. 4103

1907

Geo. L. Williams LOCATION OF SERVICE

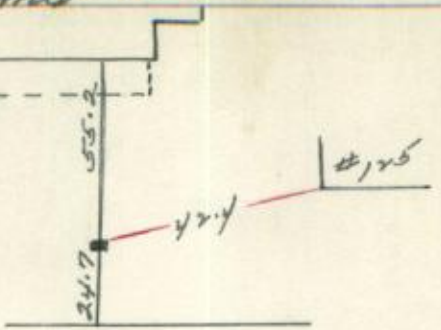

131 ov

No. 129 Hart STREET APP. No. 883

Wm A Nicol

LOCATION OF SERVICE Rem 1958

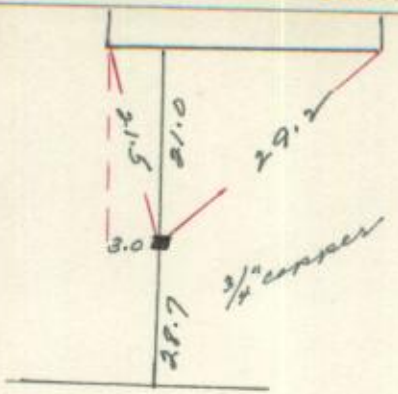

No. 133 Hart STREET APP. No. 1666

C.P. June 5, 1882

D.H LOCATION OF SERVICE Mo. C.A. May 4

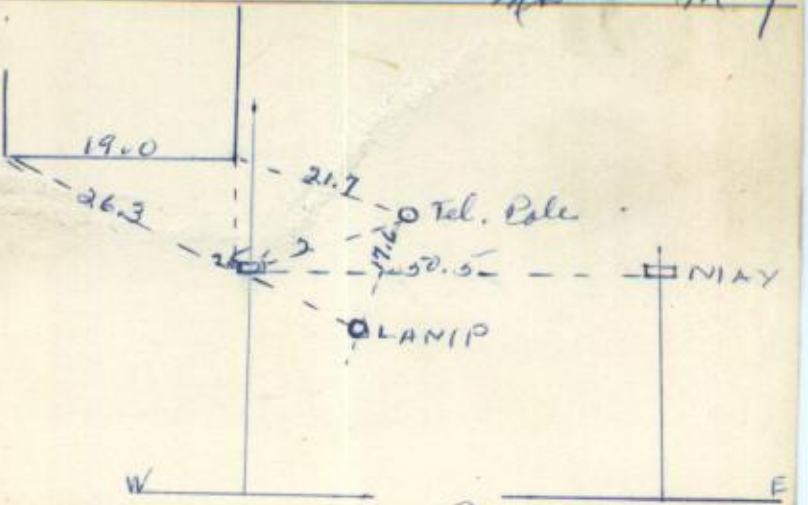

Ren: Oct 1926

No. 135 Hart STREET APP. No. 884

August 9, 1870

D. H LOCATION OF SERVICE W 48 - N Day

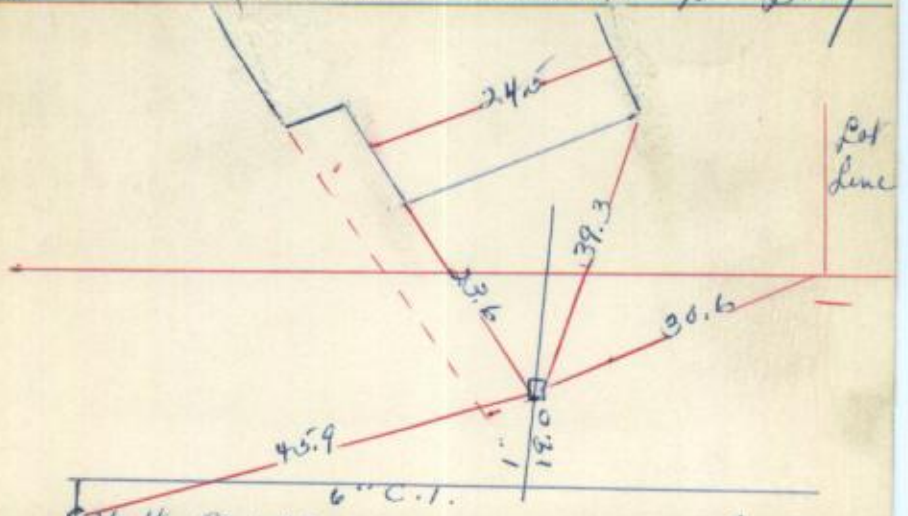

No. 137 HART ST. | STREET | APP. NO.

LOCATION OF SERVICE

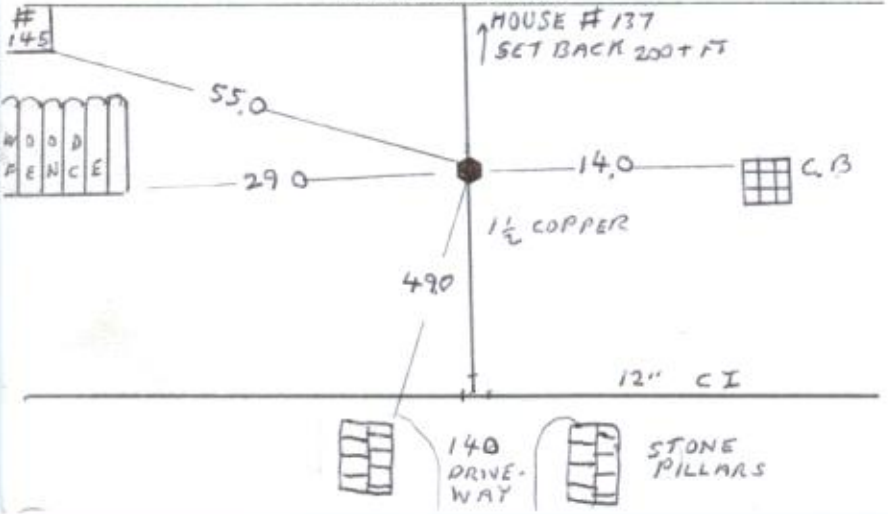

No. 140 HART ST | STREET | APP. NO. 3018

W LORING | LOCATION OF SERVICE 1896 - 2001

No. 140 Hart Street | App. No. 3018

1896

LOCATION OF SERVICE

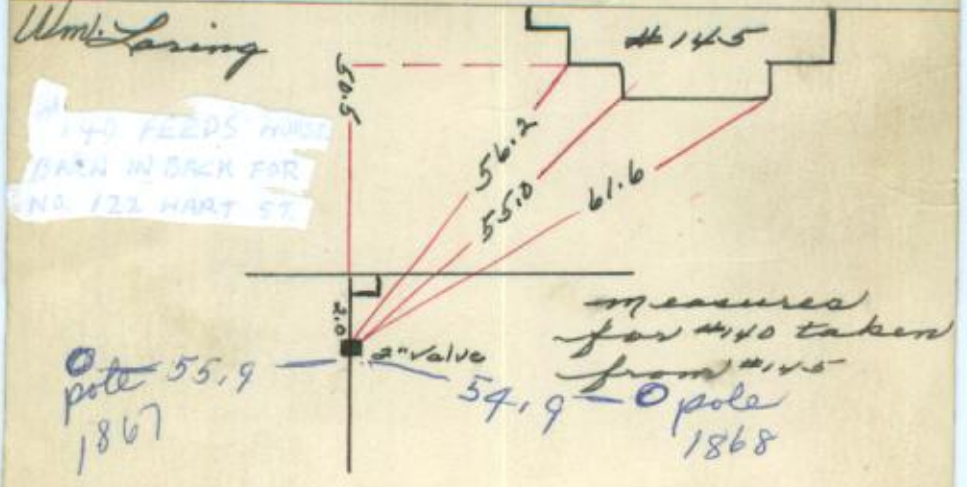

No. 145 Hart STREET APP. No. 1656

1887

LOCATION OF SERVICE July 1919

Alice Coughlan

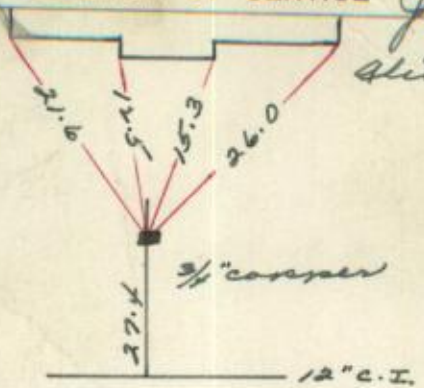

No. 154 Hart STREET APP. No. 9261

1956

R.F.D. LOCATION OF SERVICE Thomas Brady

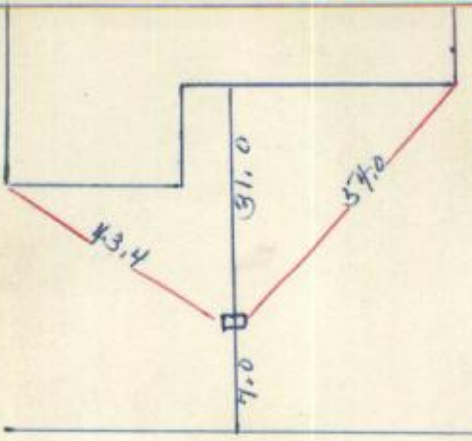

12. C. I.

No. 155 HART ST. STREET | APP. NO.

SVC OFF PRESTON PL

LOCATION OF SERVICE

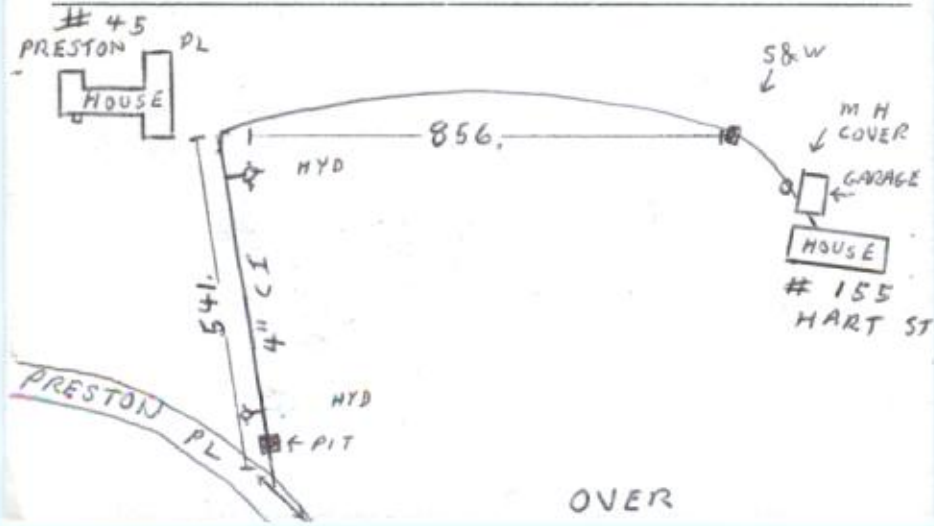

OVER

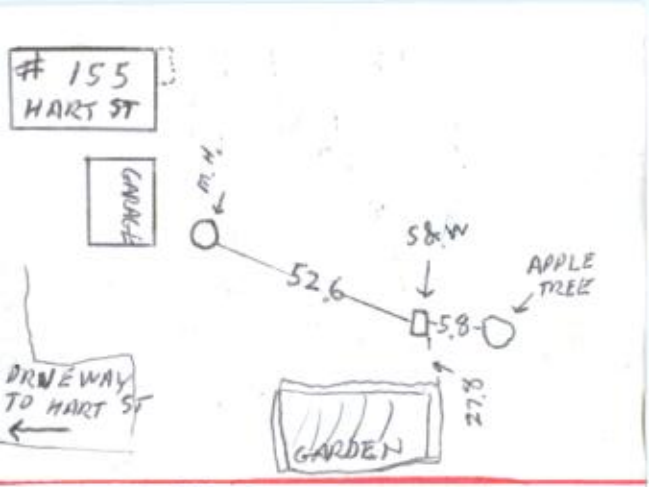
#155
HART ST
GARAGE
52.6
S&W
APPLE TREE
5.8
DRIVEWAY TO HART ST
27.8
GARDEN

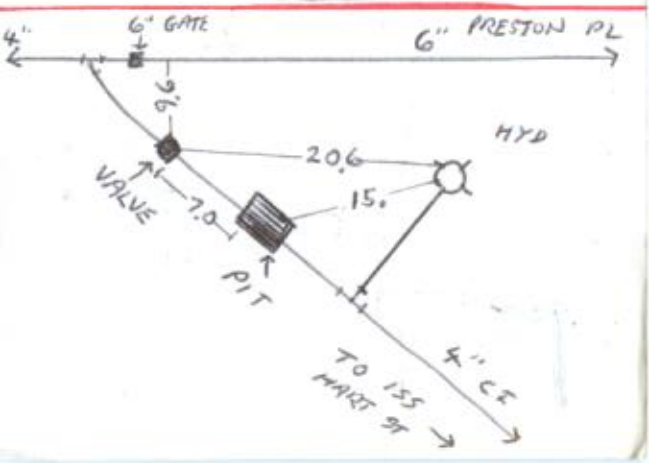
4"
6" GATE
6" PRESTON PL
9.6
HYD
20.6
15.
VALVE
7.0
PIT
TO 155 HART ST
4" CI

No. 156 Hart STREET APP. No. 885

Aug. 3, 1870

LOCATION OF SERVICE Archie. Fine

Relocation

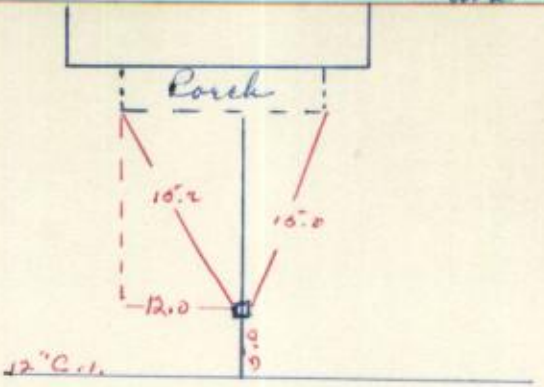

Ren: 1911

No. 158 Hart STREET APP. No. 3059

garden LOCATION OF SERVICE W. S. Styer

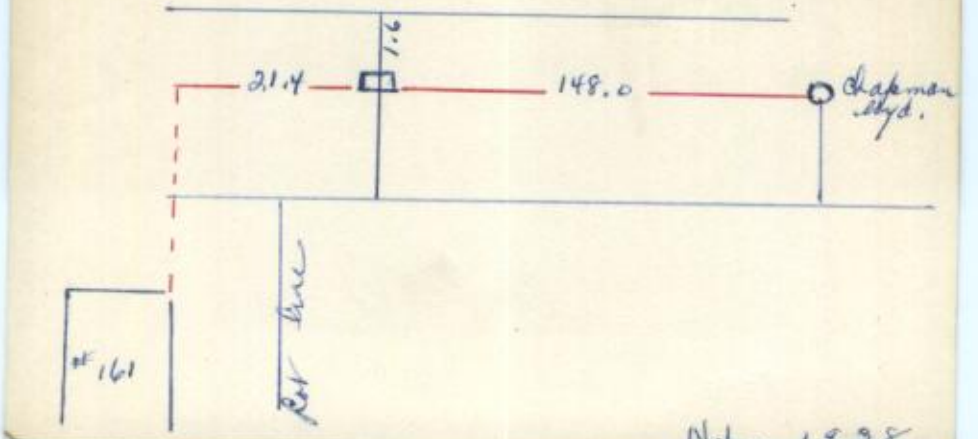

N.L. 1938

12/13/15-2 Dwg S & W 3/4" stops
2-6" nipples, 2-3/4" sleeves.

No. 158 Hart (off Dyer Rd) STREET | APP. No. 9263

June 5, 1956 LOCATION OF SERVICE Roger T. Nihen

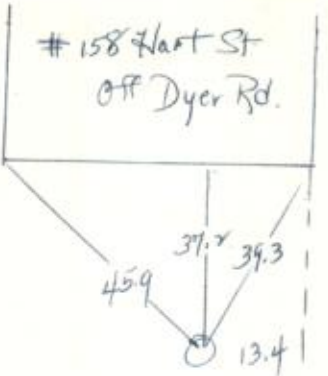

No. 160 Hart | Off Dyer Rd | STREET | APP. No. 9591

New Inc. Nov. 16, 1961 LOCATION OF SERVICE Warren A. Gray

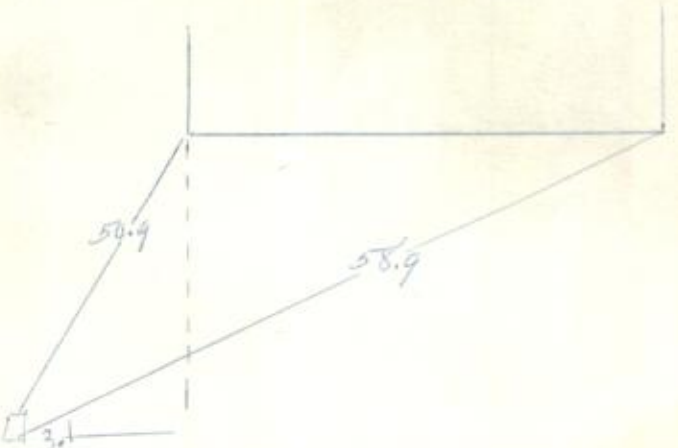

No. 161 HART ST | STREET | APP. NO. 2116

LOCATION OF SERVICE

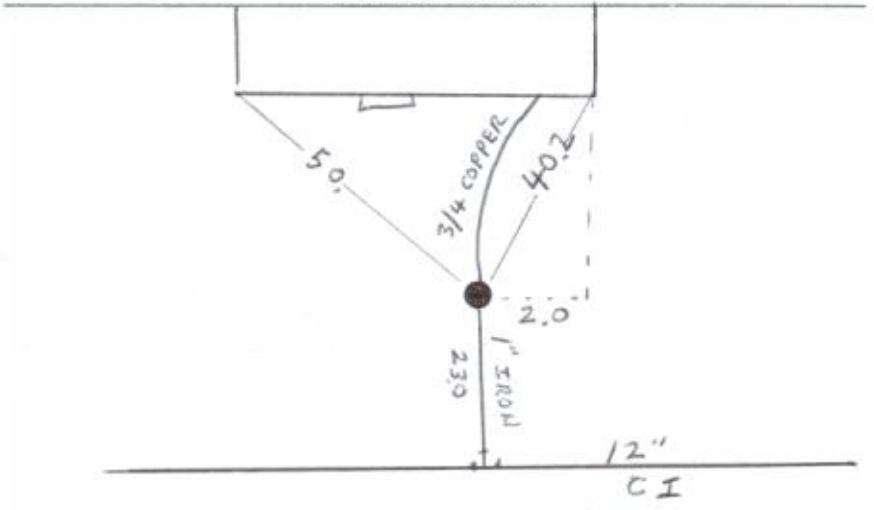

1-5-08 LEAK ON S&W. 1" REPAIR
SLEEVE, 1 6" BRASS NIPPLE
1 x 3/4 F. ADAPTOR. 1-3/4 COMP UNION.

No. 171 Hart STREET APP. No. 3040

C. P. R. Sept 28, 1896

LOCATION OF SERVICE Paul P. Fiore

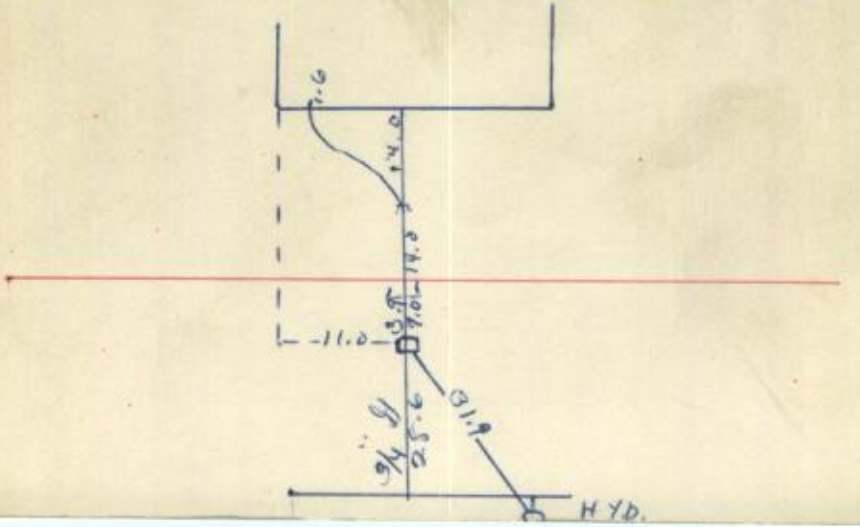

8/11/44 - Proofed O.K.

No. 183 Hart STREET APP. No. 4526

installed 1920

Aug. 29, 1966 LOCATION OF SERVICE John D Horvit

New Tap -

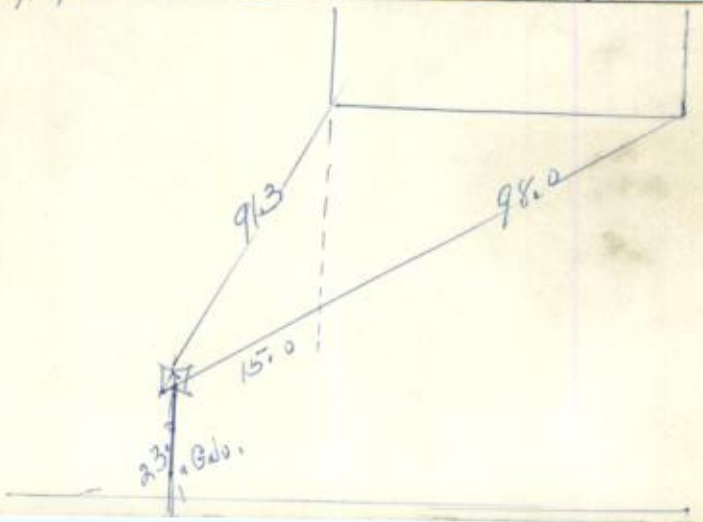

No. 184 Hart st | STREET | APP. NO. 7/10/09

LOCATION OF SERVICE

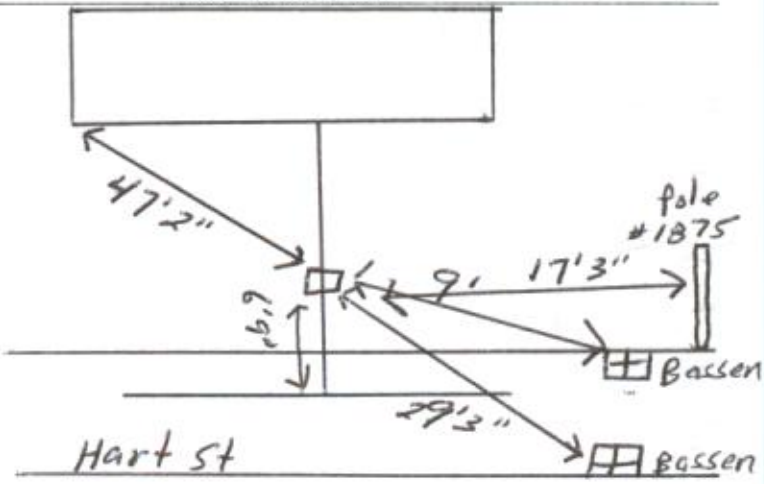

7/10/09 Replaced water service 1" copper main To House

No. 185 Hart STREET APP. No. 1761

New loc - Aug 29 1966 LOCATION OF SERVICE Wm Pt Helen C Brotherton

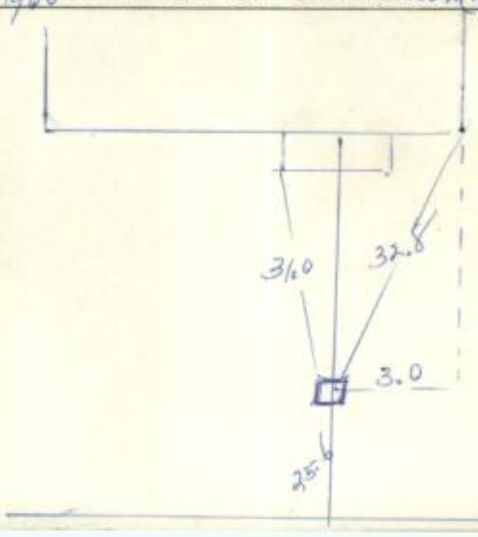

No. 185 Hart STREET APP. No. 1761

C.I. Oct 4, 1883

D.H LOCATION OF SERVICE Norman J Bennett

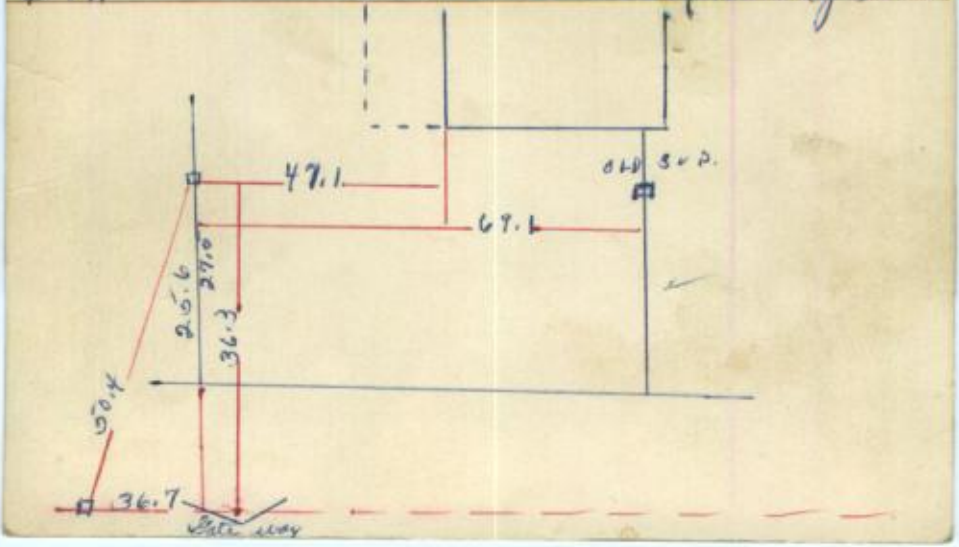

Ren to st. Line Apr 1927, NL 1919

7/20/54 - Sealed O.K

Eng. on S.N. 1-8" nipple
1-1" sleeve, owner pat, copper 0.8
of S 21

No. 186 Hart STREET APP. No. 886

DH LOCATION OF SERVICE Marion Stewart

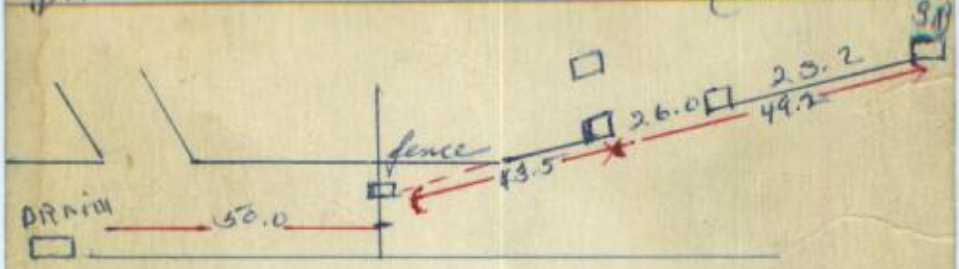

Ren Mar 1927 M.L. 1938

6/46 - Leaked - O.K

12/2/53 - Removed ~~mandrel~~ stop
18" of C.I.P. - stop.
Owner ran 1½" tubing
to stop.

No. 189 Hart | STREET | APP. No. 10449

Apr. 4, 1962 (N Serv.) LOCATION OF SERVICE

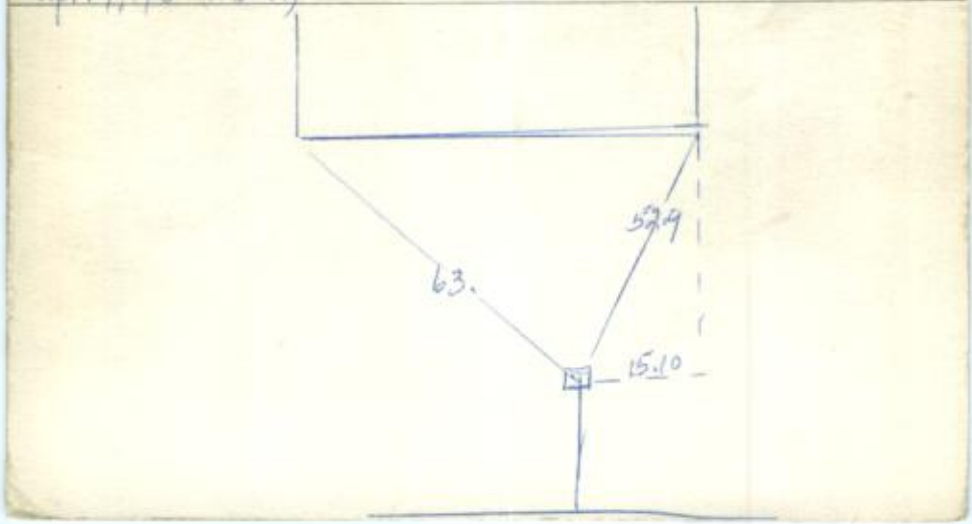

(New Location)

No. 196 Hart Street | App. No. 887

Aug. 5, 1870.

D. H LOCATION OF SERVICE W. S. Spaulding

(Service Boy is 1.0 ft in Back of Fence)

No. 196 Hart STREET APP. No. 887

June 5, 1969 LOCATION OF SERVICE
New Service

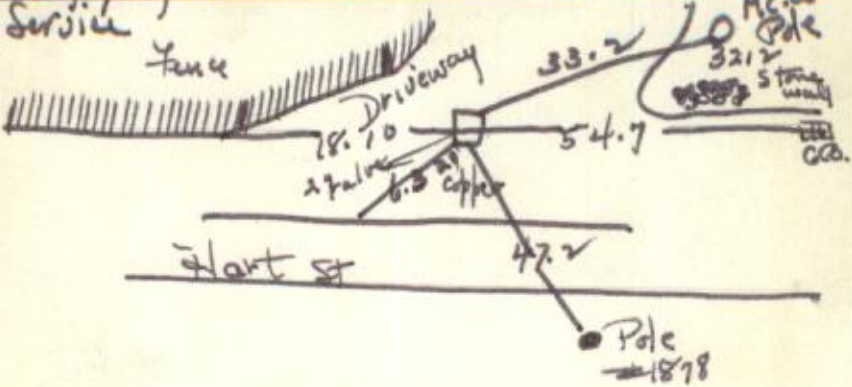

No. 208 Hart STREET APP. No. 6679

J.V.B Apr. 6, 1933

garden LOCATION OF SERVICE B.M. Hall

No. 209 Hart STREET APP. No. 2140

C. P. Sept. 2, 1857

D. H LOCATION OF SERVICE Riley Mayberry

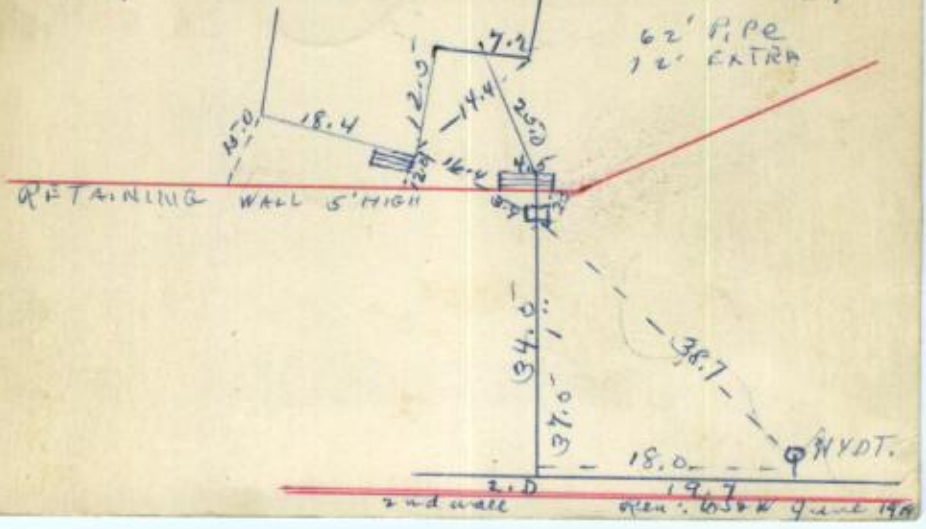

Ruled 9/8/44 - O.K.

No. 211 HART STREET | APP. NO. 12578

1988

LOCATION OF SERVICE

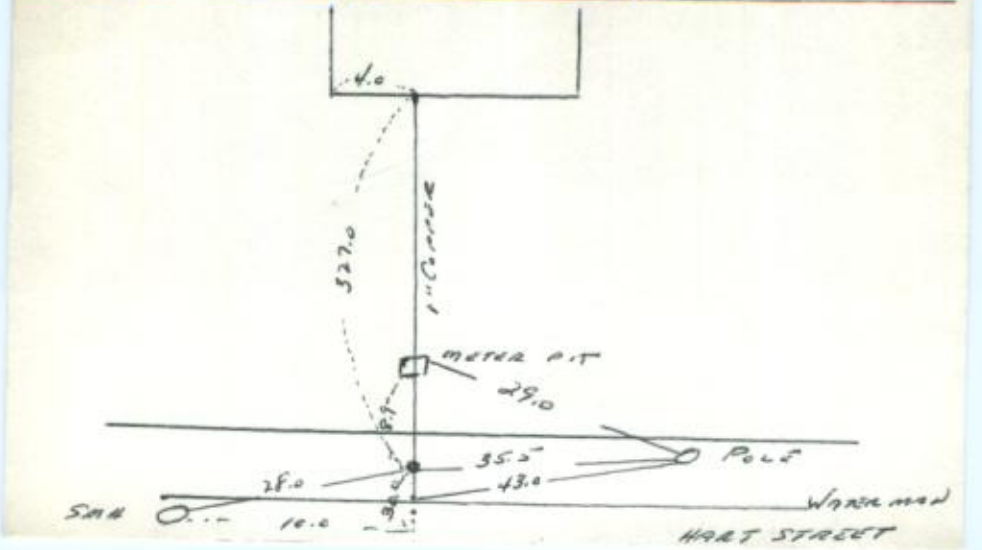

No. 212 Hart STREET APP. No. 18,447

Rt. side Apt

Hobbs

LOCATION OF SERVICE

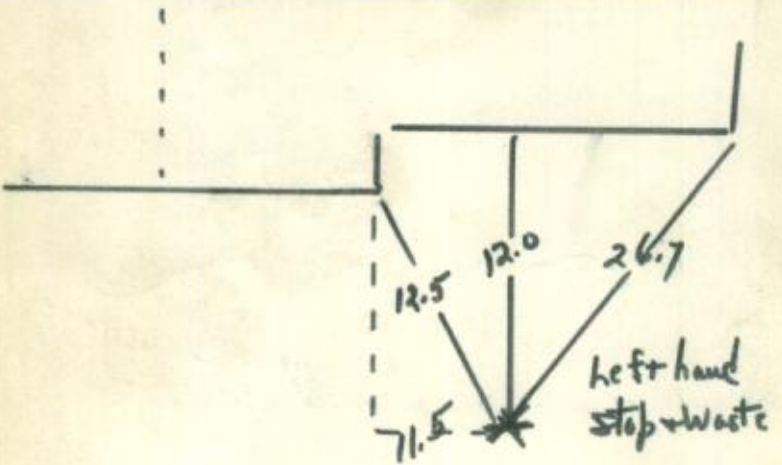

No. 212 Hart STREET APP. No. 10,417

LOCATION OF SERVICE (Paul)

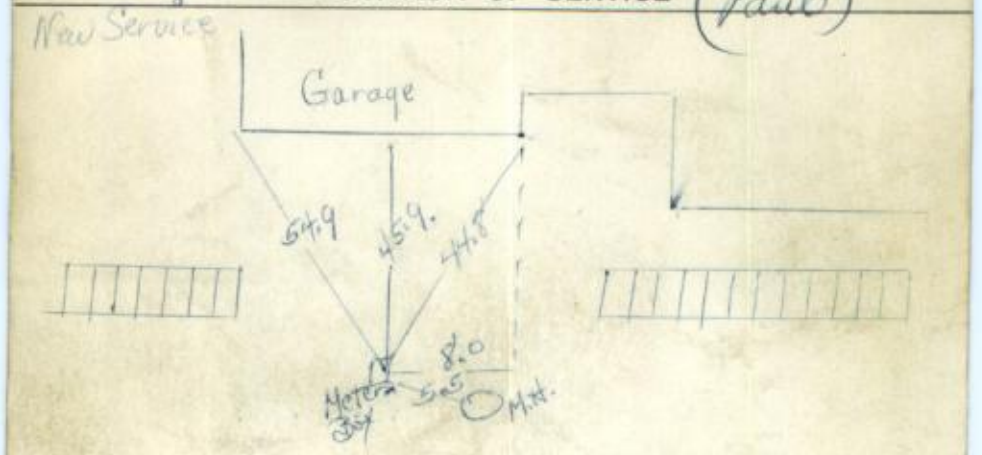

No. 215 HART-ST STREET | APP. No. LOT # 2 11959

Installed 3-1-83 Jeffery Silva

LOCATION OF SERVICE

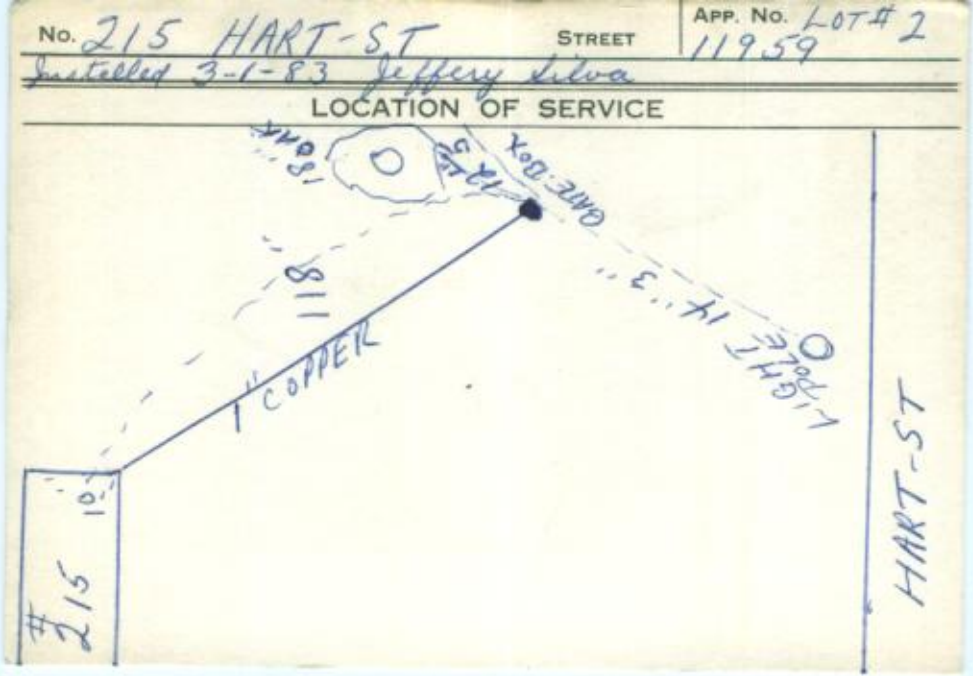

No. 218 Hart St STREET | APP. No. 11771

New Service

LOCATION OF SERVICE

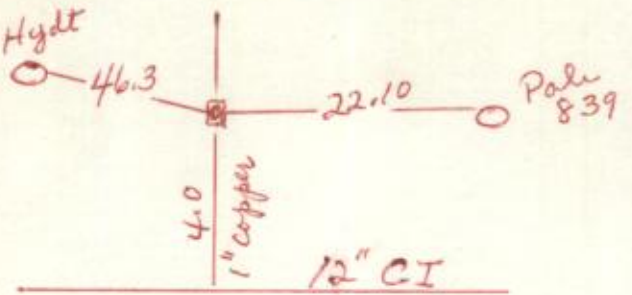

No. 220 Hart STREET APP. No. 8840

R.F.D. March 17, 1954

D.H LOCATION OF SERVICE Mrs. H. Jacques

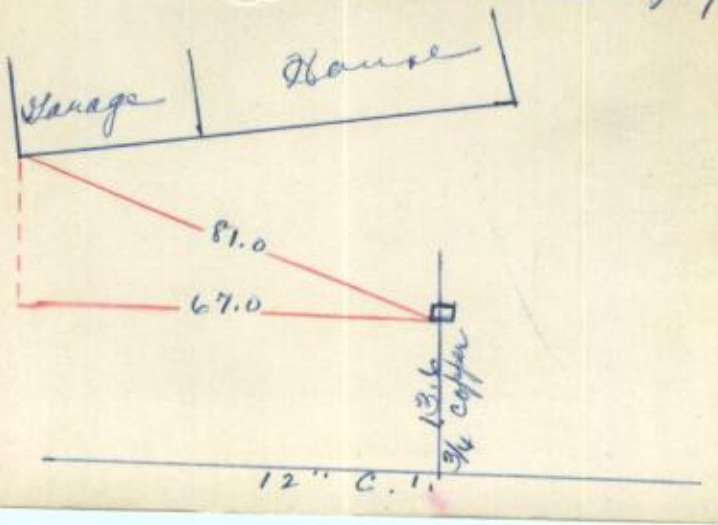

No. 249 Hart STREET APP. No. 2623

C.P. June 29, 1893

D H LOCATION OF SERVICE Close P. Grade

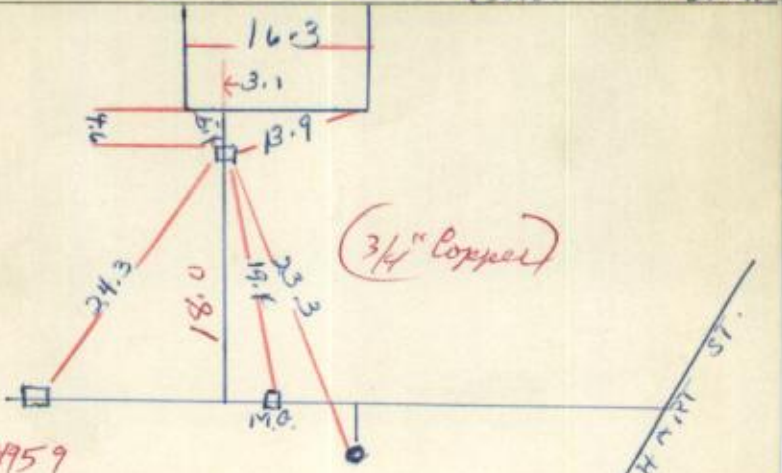

Ren Sept 1959

Ren Oct 1918

N.L. 1919

11/21/50 - Probed excellent

No. 261 Hart St | STREET | APP. NO. 891

service on Preston Place

LOCATION OF SERVICE 7/14/10

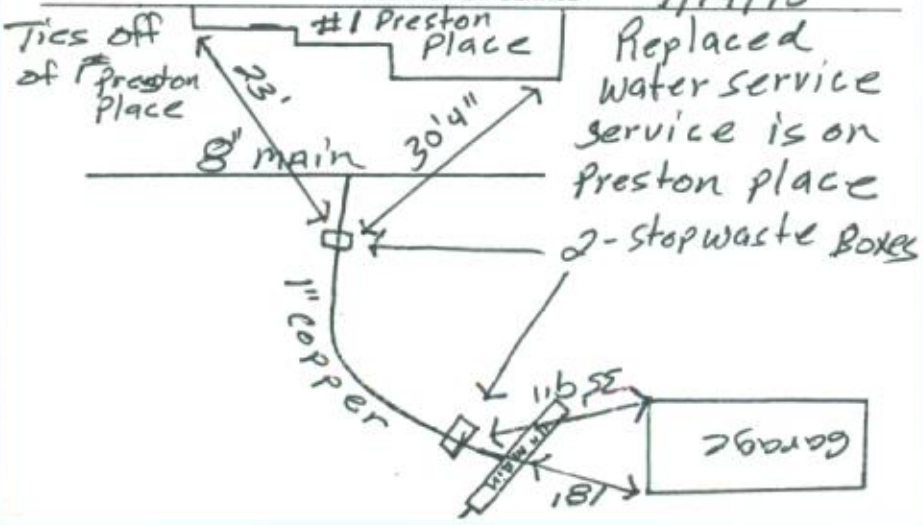

Replaced

No. 261 Hart St 7-14-10 STREET | APP. NO. 891

LOCATION OF SERVICE

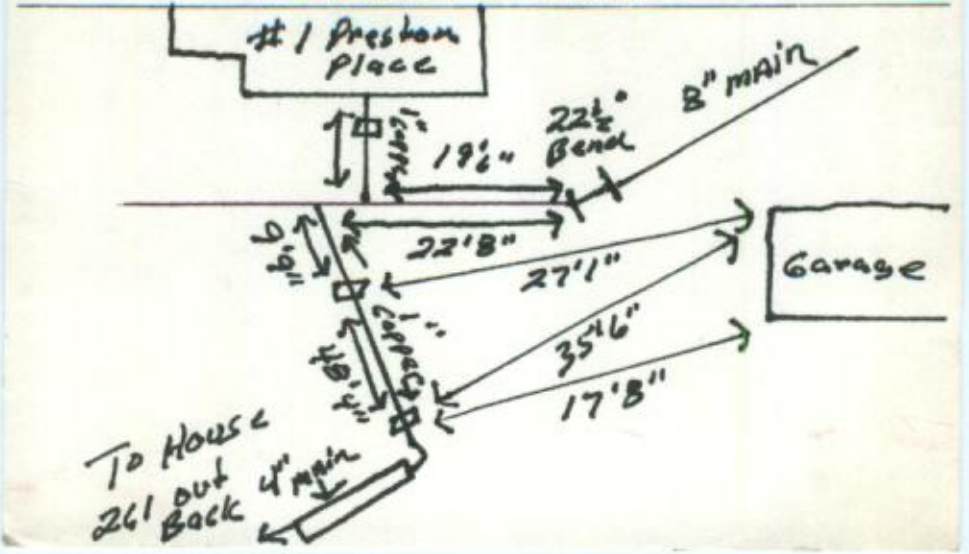

No. Baptist Church (Hart) STREET APP. No. 2424

New Loc. May 9, 1960 LOCATION OF SERVICE

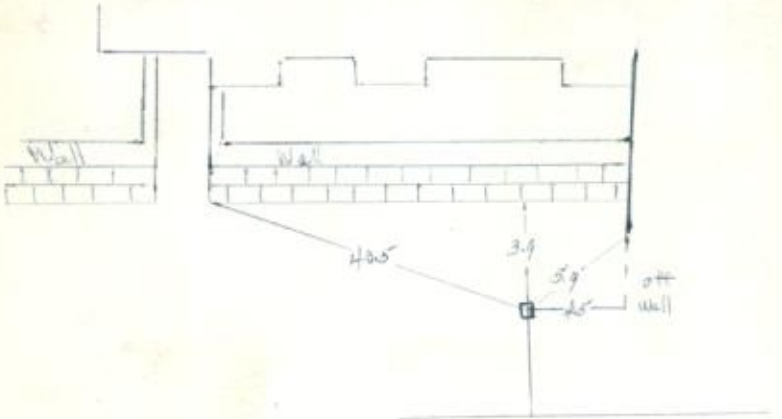

No. Bank STREET | APP. No. 1416

September 20, 1886

Fountain LOCATION OF SERVICE City of Beverly

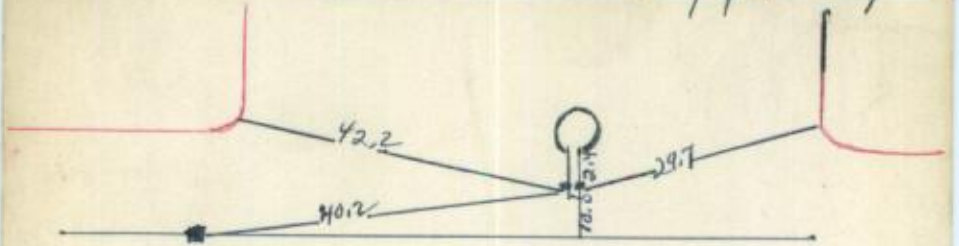

No. Hart STREET APP. No. 5906

J.W.B. Nov. 21, 1924

Greenhouse LOCATION OF SERVICE Halifax Garden Co.

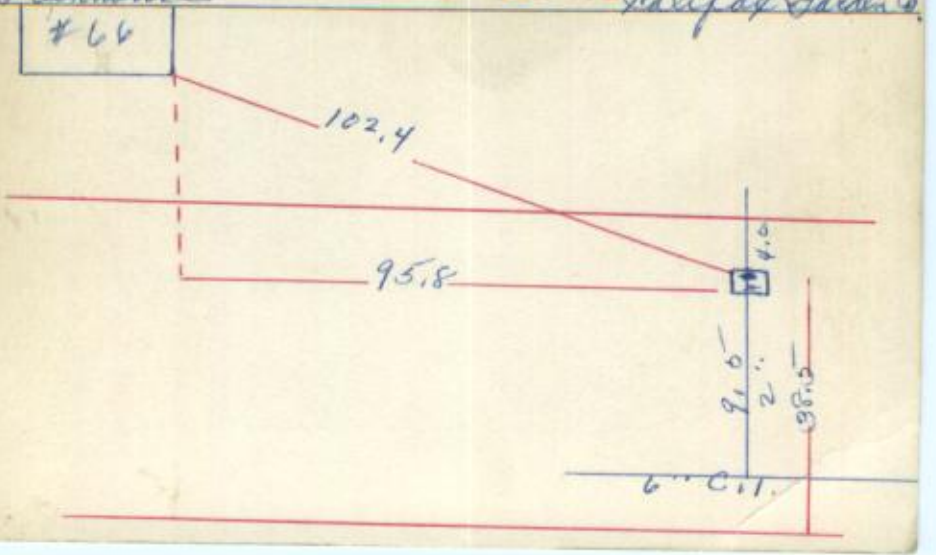

No. 1 East STREET APP. No. 3982

2 W 13 Sept 27, 28, 1906

Stable LOCATION OF SERVICE Riley, Mayhew

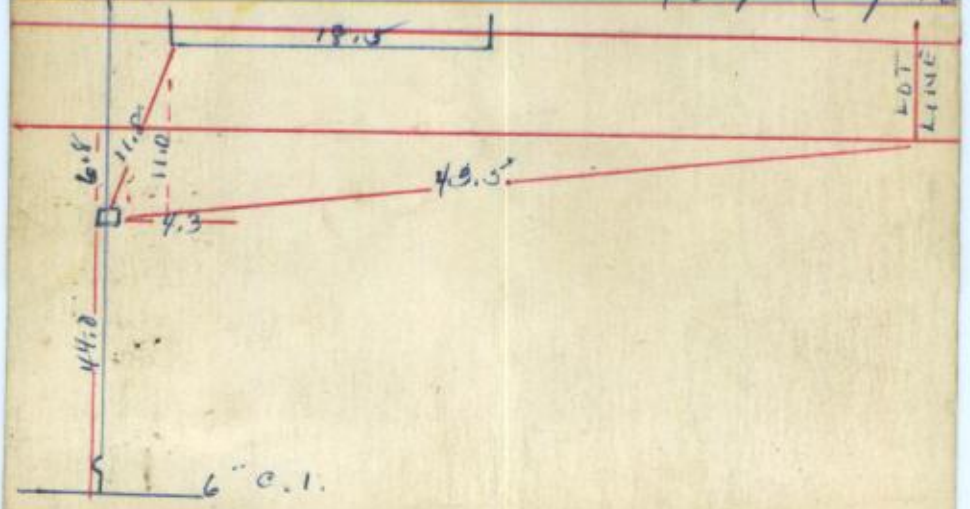

No. Hazel (Near Washington Ave) STREET | APP. No. 5446

J. C. B. April 18, 1917

D. H LOCATION OF SERVICE G. H. Nightingale

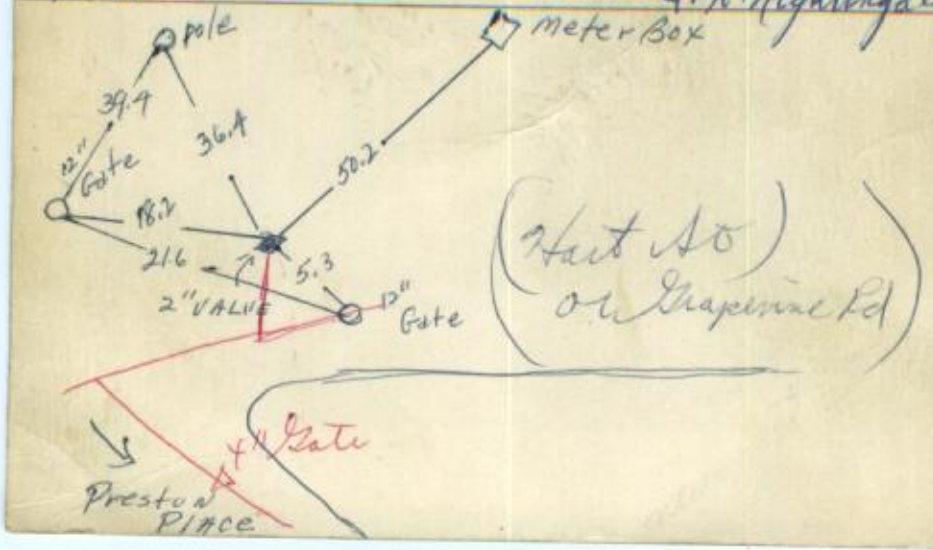

No. Hart STREET APP. No. 4533

Y.M.C.A. July 22, 1910

D.H LOCATION OF SERVICE Kansas Hotel

new location

No. 2 Hull (Measure Off) STREET APP. No. 1344 ~~1348~~

W.h. June 18, 1962 LOCATION OF SERVICE Jos. Pettipas

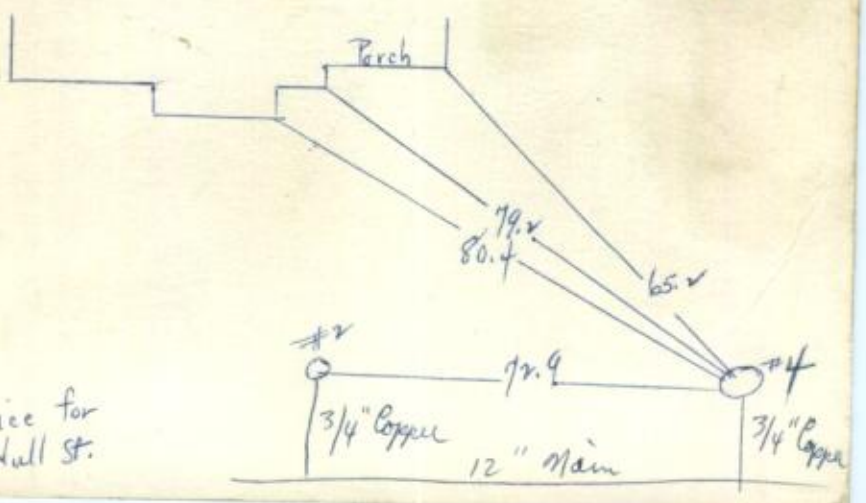

Service for #4 Hull St.

No. 2 (Wenham) Hull St STREET APP. No. 7517

A.H.R Augi2, 1948

D.H LOCATION OF SERVICE Henry McLean

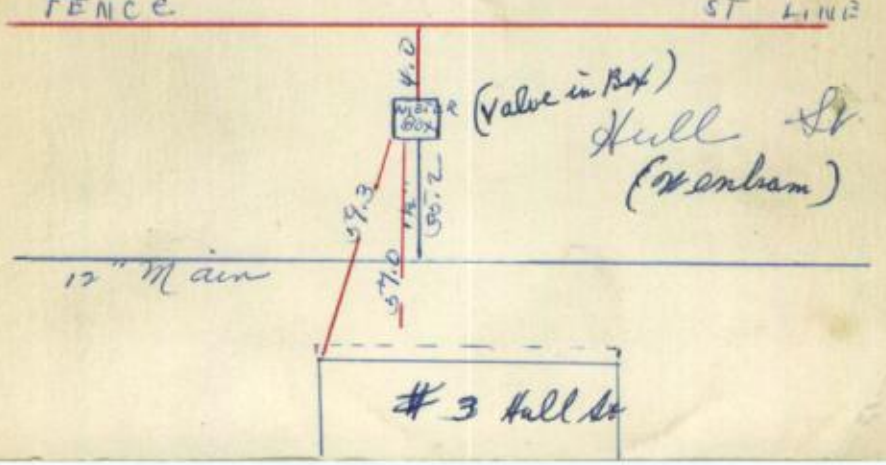

No. 2 Hull STREET Oak APP. No. 3175

S. W. 13. Jno. Pattison

D. H LOCATION OF SERVICE

NEW LOCATION
6-18-62

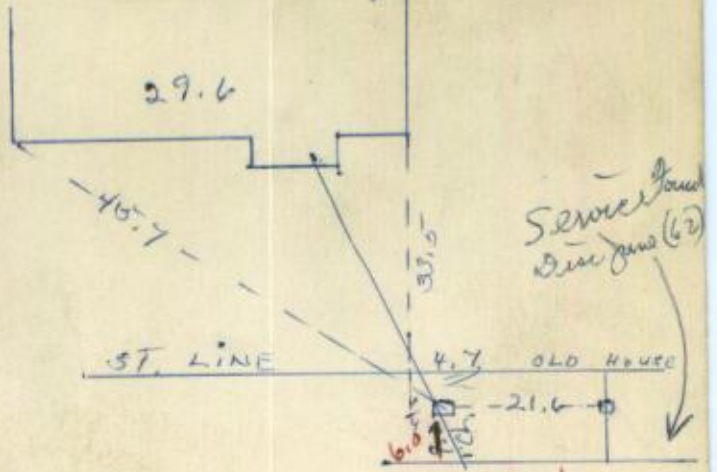

Rec June, 1948

No. 3 Hull (Wenham) STREET | APP. No. 7153

A.H.R. June 26, 1945

D.H LOCATION OF SERVICE Dead End Tweedy

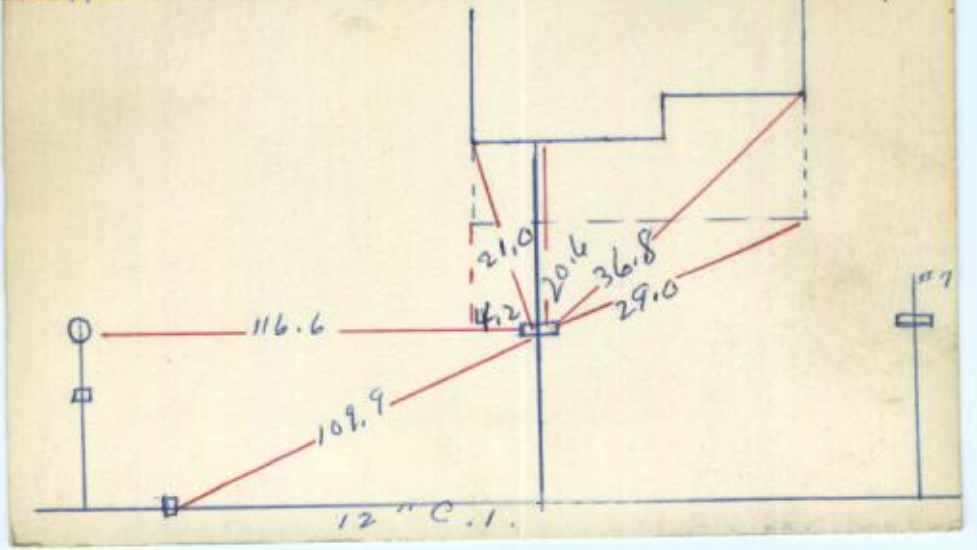

No. 5 Hull St. (WENHAM STREET | APP. No.

Addie Hellman

LOCATION OF SERVICE

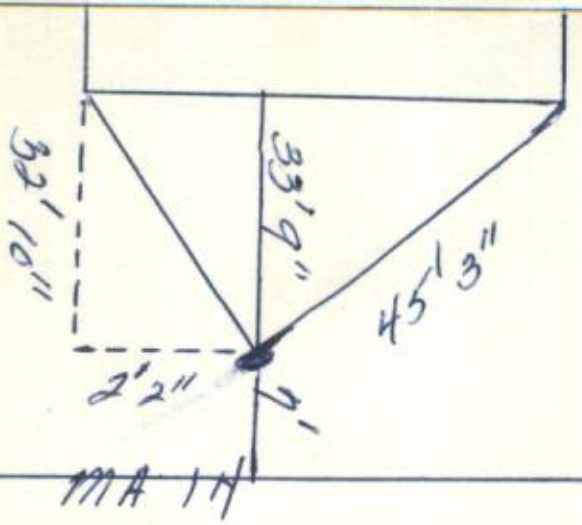

No. 7 Hull (Nahlem) STREET | APP. No. 7148

A.H.R. June 18, 1945

D.H. LOCATION OF SERVICE Cpl. A. Williams

2nd house

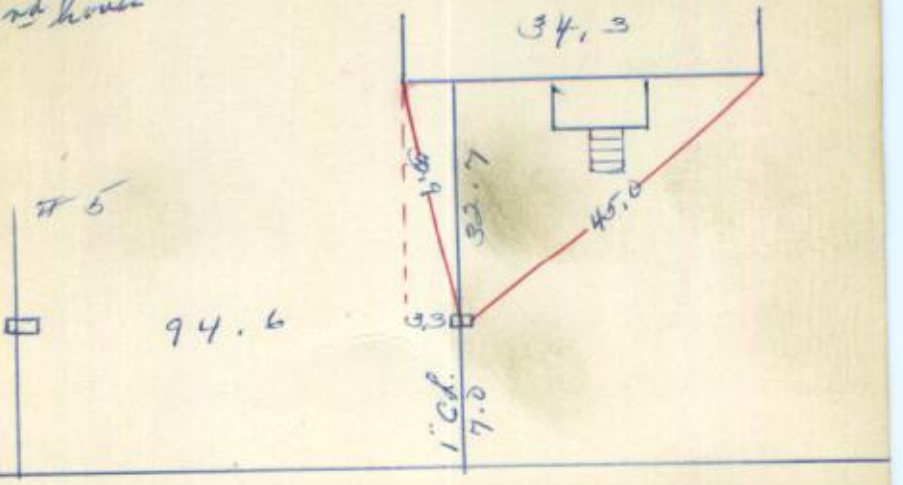

No. 8 Hull | STREET | APP. No. 6692

J.W.B. | June 9, 1939

P. H | LOCATION OF SERVICE | Robert B. Beach

8-24-62
3/4 COPPER
MAIN TO S&W

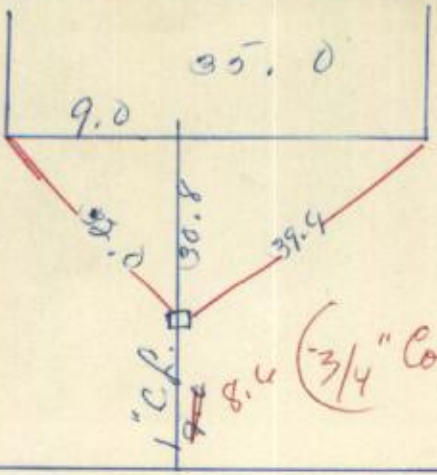

No. 7 Hull (Wenham Street) App. No. 7419

A.H.R. Oct 20 1947.

D. H LOCATION OF SERVICE Cor. A. Williams

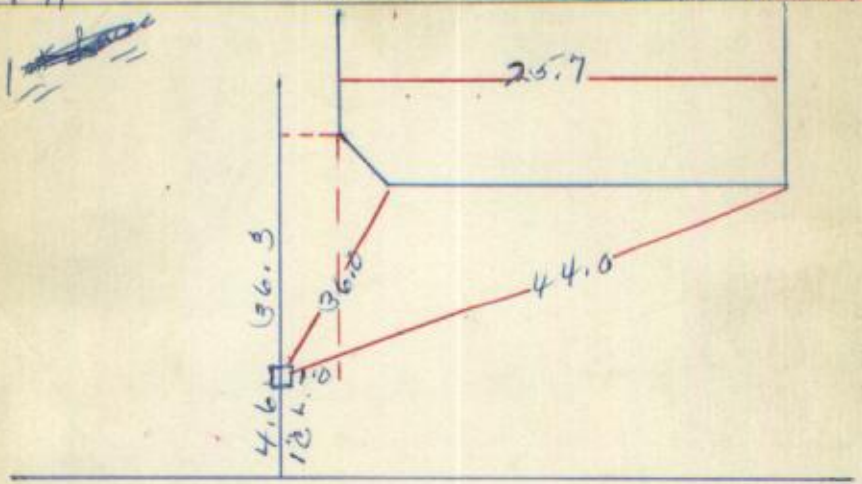

No. 9 Hull Street STREET | APP. NO. 1237

1991

LOCATION OF SERVICE

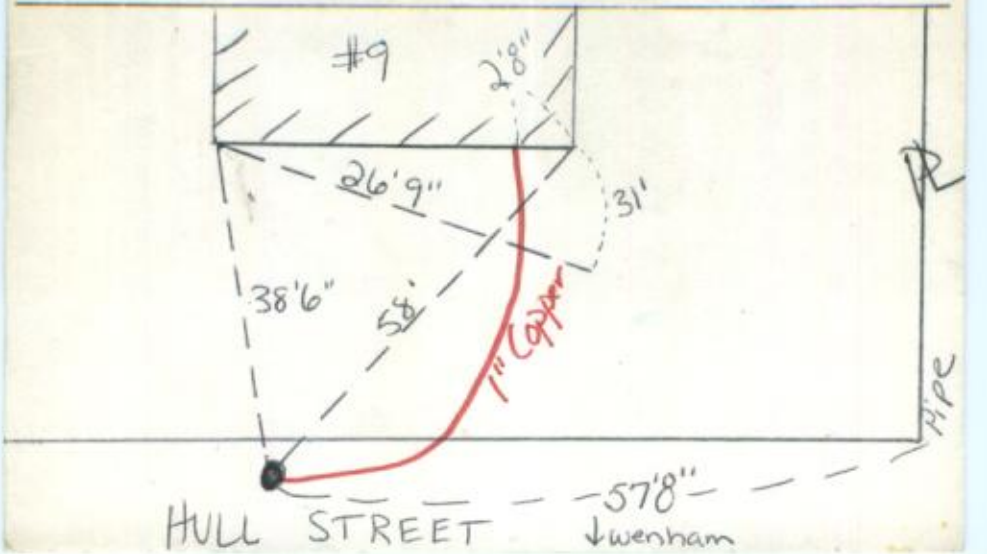

No. 12 Hull STREET APP. No. 6118

D. H. B. 3rd Augt 29-1927

D. H. LOCATION OF SERVICE Mrs. B. Jordan

(Renewed June 3, 62)

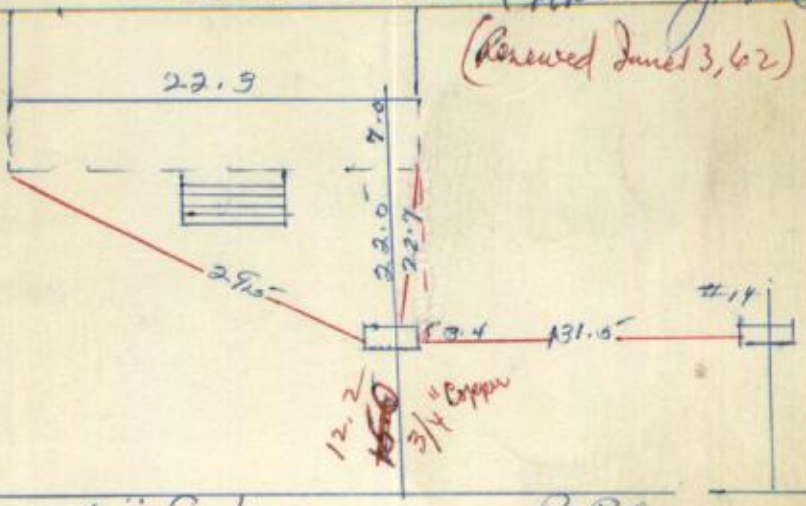

Aug 6 — 5 1 - Brookfield Farm
Tilling near To [illegible]

No. 13½ Hull ST STREET | APP. No. 11753

LOCATION OF SERVICE

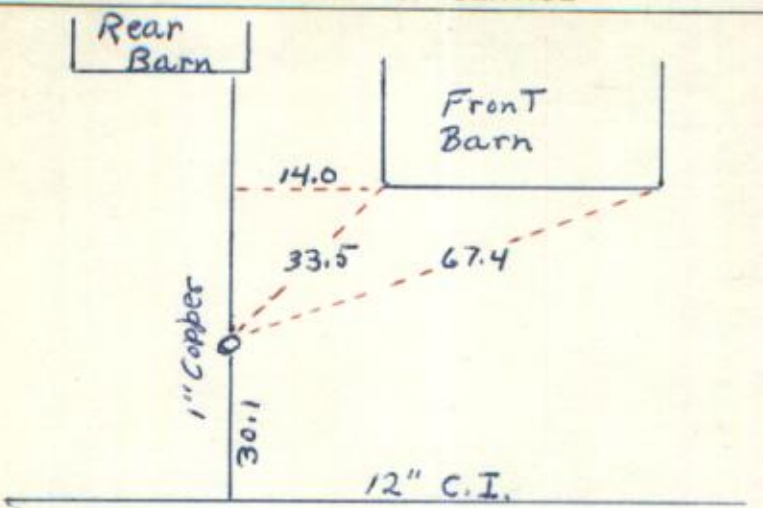

No. (13) Hall (Wenham) STREET | APP. No. 6911

a.N.R. Sept 7, 1909

D.H LOCATION OF SERVICE G. A Williams

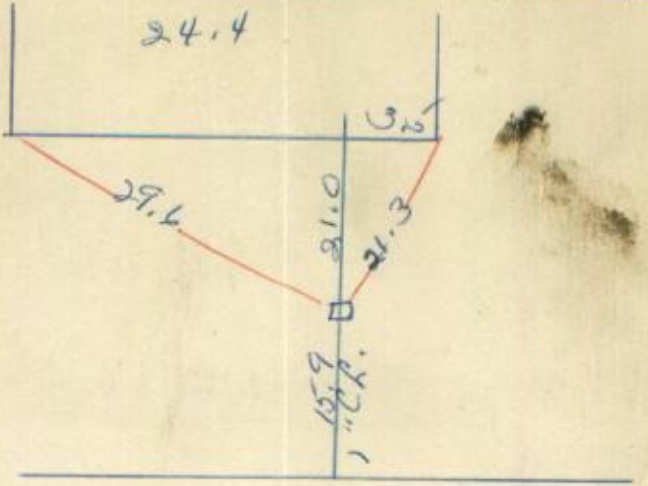

No. 14 Hull | STREET | APP. No. 5260

(N)

Ren. May 27, 1960
M to stop 3/4" Copper

LOCATION OF SERVICE Angelo Pinciaro

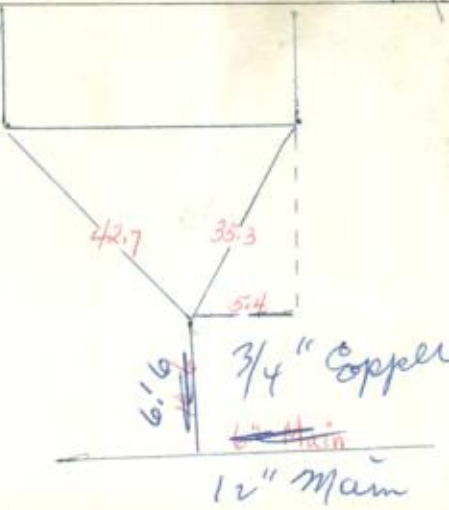

No. 15 Hull STREET APP. No. 979

August 4 1871

D.H LOCATION OF SERVICE Arthur Court

(Renewed June 1962)

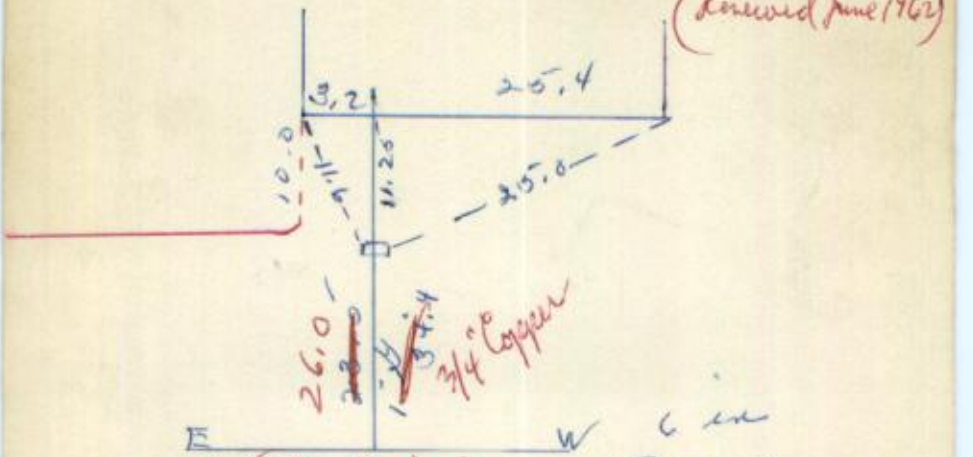

Ren: Nov 1917

11/19/48 Rusk

No. 16 Hull (Wenham) STREET

APP. No. 10,061

H. P. McLeod

1958

LOCATION OF SERVICE

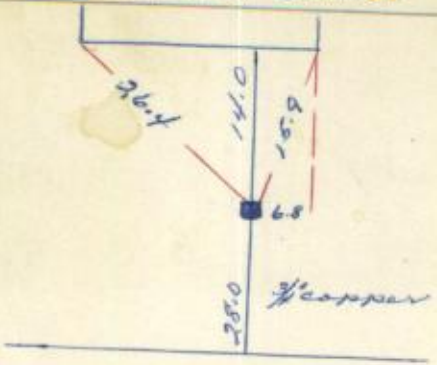

No. 18 Hull STREET APP. No. 7926

R. T. D. May 8, 1947

D. 17 LOCATION OF SERVICE Chester Ball

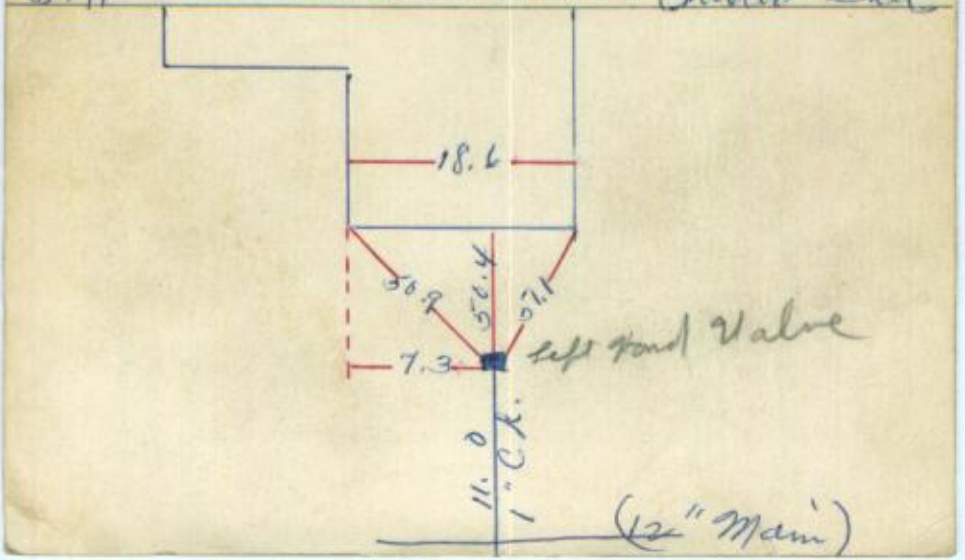

No. 19 Hull | STREET | APP. No. 9340

New Loc - Sept. 4, 1956 LOCATION OF SERVICE Donald E. Crandall

1956 - COPPER HOUSE TO S&W

No. 20 Hall Street App. No. 6852

G.W.R. Feb 3, 1939.

D.H. LOCATION OF SERVICE Walter Dana

(Renewed June 21, 1962)

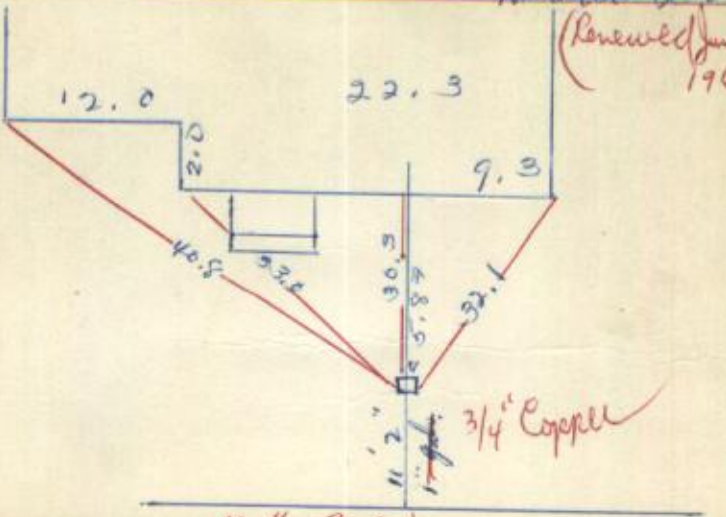

No. 21 Hull STREET APP. No. 9072

July 25, 1955

D. H LOCATION OF SERVICE J. M. Crandall

6" OF 3/4 COPPER
S&W TO ST. LINE

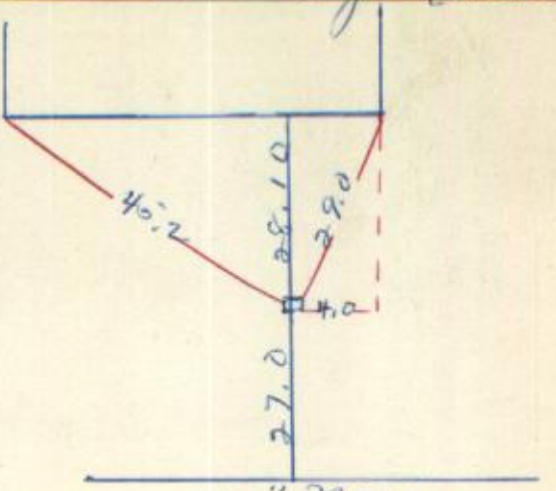

No. 22 Hull STREET | APP. No. 8634

Nov. 24, 1952

D. H LOCATION OF SERVICE Hamil Mills

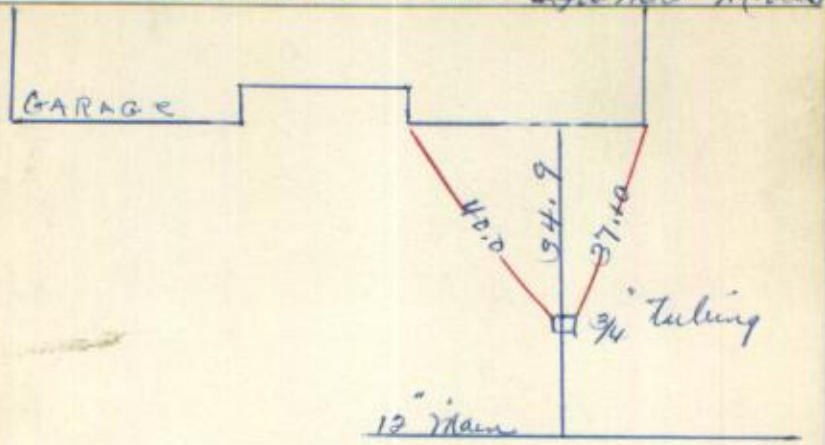

No. 24 Hull | STREET | APP. No. 7700

New Loc - Oct 31, 1961 LOCATION OF SERVICE Robert Harrington

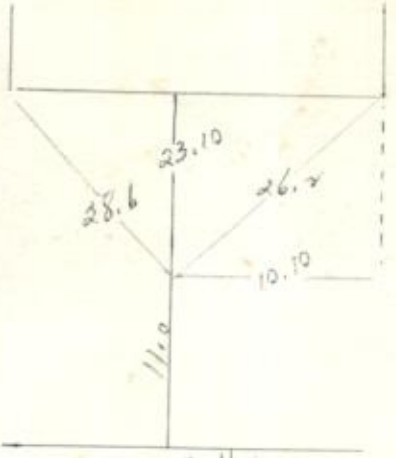

1969
1" COPPER MAIN
TO S&W

No. 25 Hull STREET APP. No. 2437

Newhac. June 13, 1962 LOCATION OF SERVICE W.S.Sab

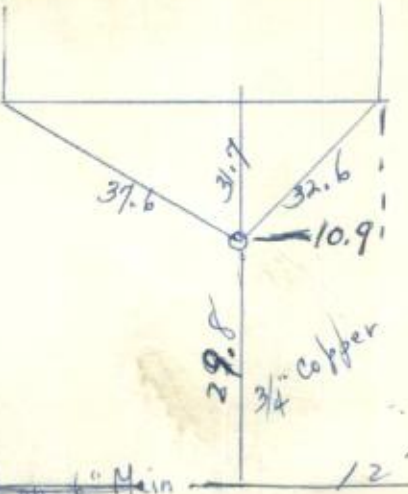

No. 26 Wenham Hull St (Cottage) STREET | APP. No. 7428

A H R. Dec 18, 1947

D. H LOCATION OF SERVICE Henry McLean

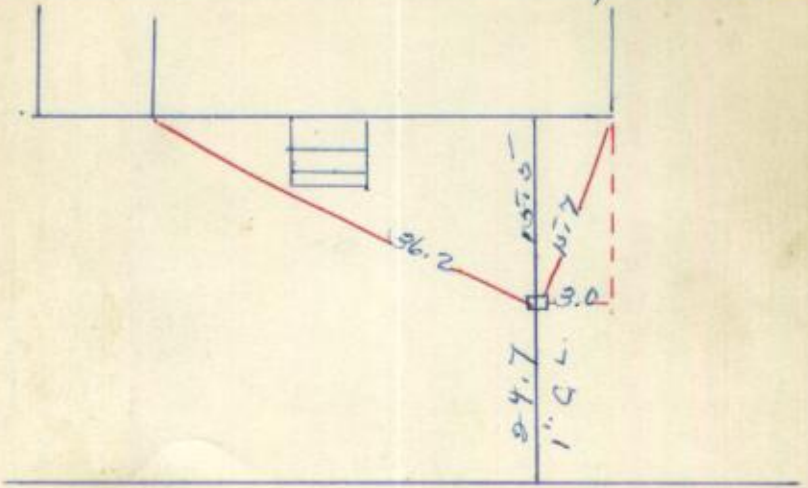

No. 28 Hull STREET APP. No. 7700

A.G.R. April 7, 1949.

D.H LOCATION OF SERVICE S.A. Elliott

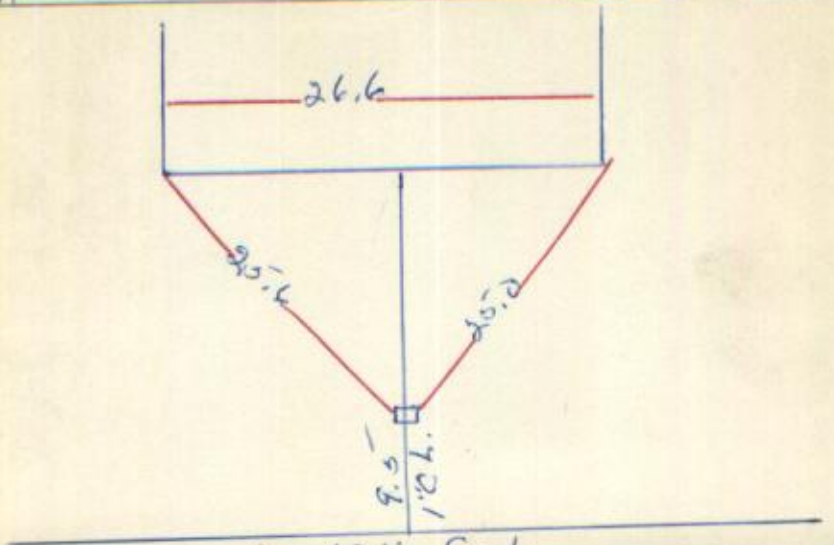

No. 29 Hull St | STREET | APP. NO.

LOCATION OF SERVICE

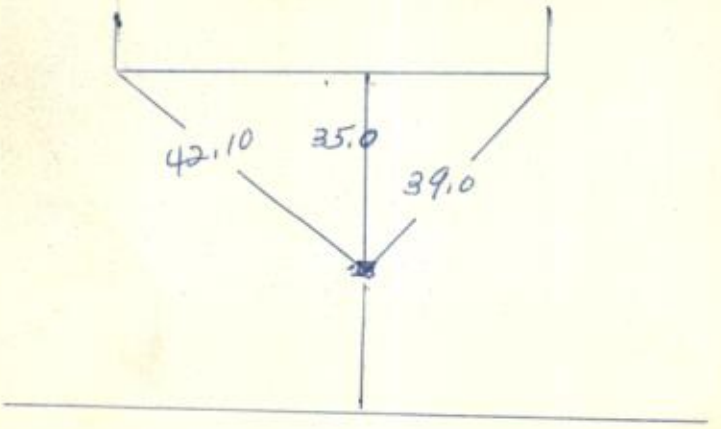

No. 30 Hull STREET | APP. No. 6875

Newbse - 1962 LOCATION OF SERVICE John J. Lynch

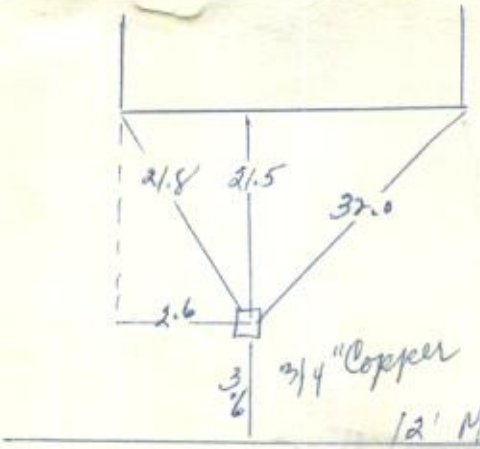

No. 32 Hull STREET APP. No. 9041

June 20, 1955

D.H LOCATION OF SERVICE Cedric S. Robb

(Renewed 1962)

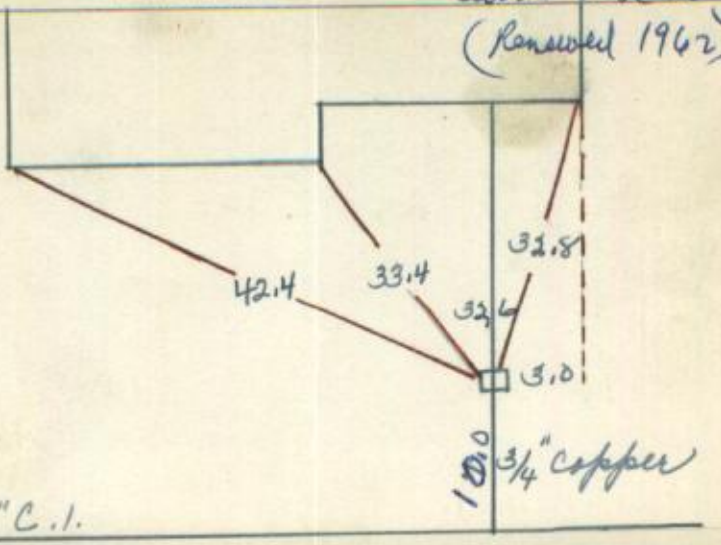

No. 34 Hull (Garden Terr.) STREET | APP. No. 3400

S.W. 83. June 4/1900

Pasture LOCATION OF SERVICE Owen Appleton

(Renewed July 1962)

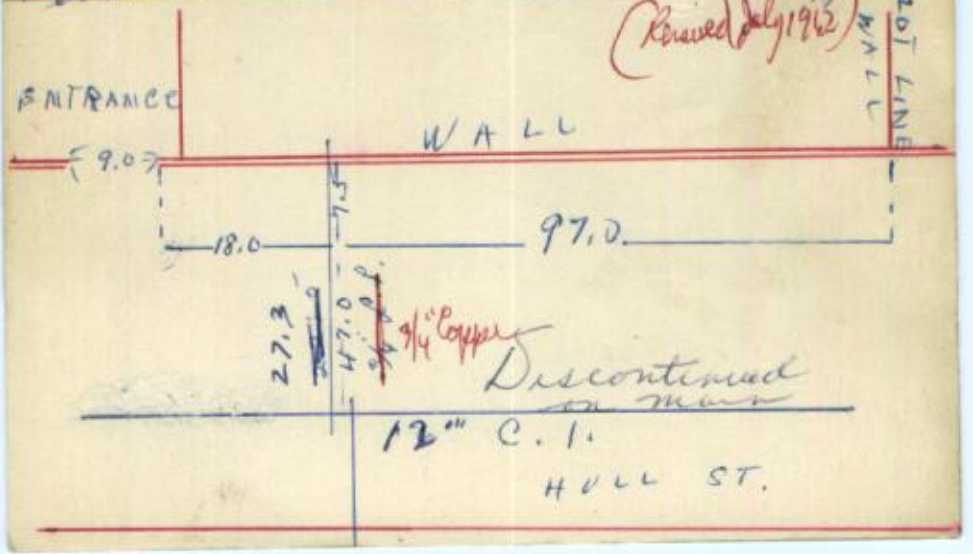

No. 34 Hull Street | APP. No. 8201

E. F. H. Dec. 4, 1950

S. H LOCATION OF SERVICE Frances Hallett

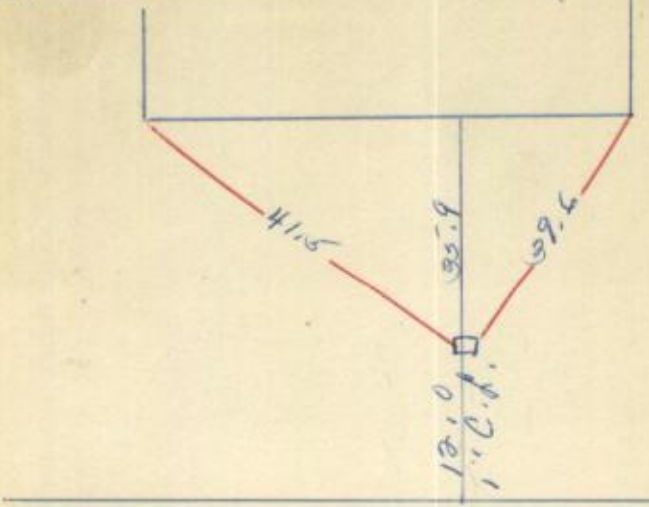

No. 34 Hull or #36 STREET | APP. No. 8409

New hse. July 15, 1961 LOCATION OF SERVICE N

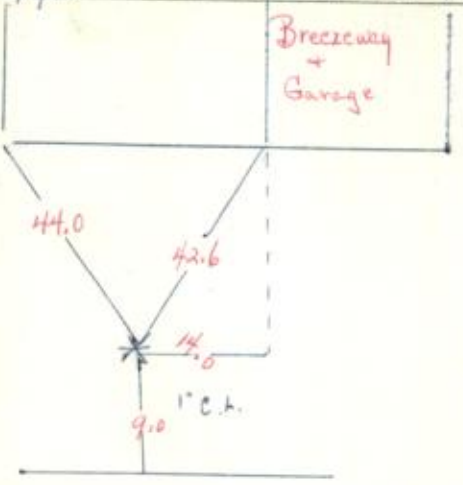

No. 35 Hull | STREET | APP. No. 11294 ~~6875~~

Measures for LOCATION OF SERVICE ~~John T. Haynes~~

#35 Hull St - 1½" Serv. off 30 Hull

~~Mar. 27, 1939~~
New Serv. 1972

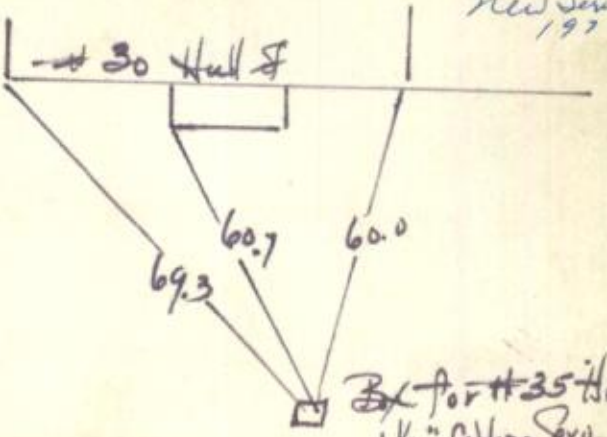

No. 35 Hull | STREET | APP. No. 11294

New Service LOCATION OF SERVICE Spear

1972 - Measures from 30 Hull St. - for 2-1" Corp. @ 35 Hull

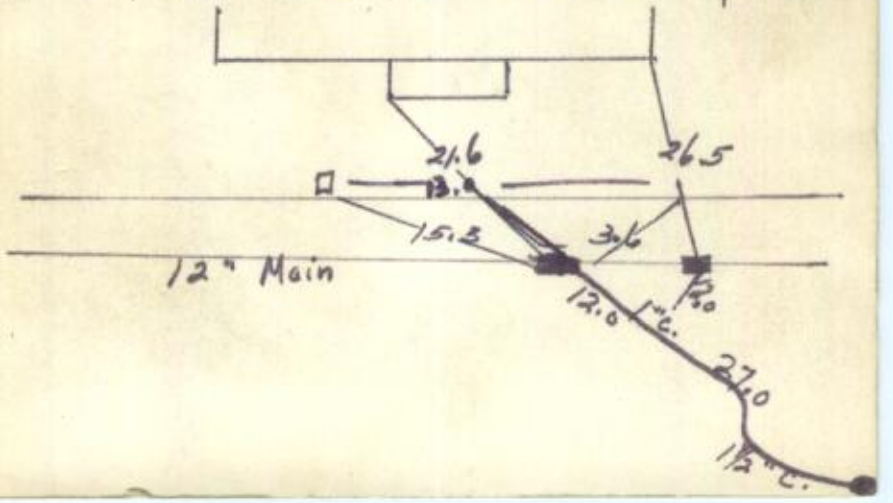

No. 35 Hull STREET APP. No. 1774

Dec. 7, 1883

D. H LOCATION OF SERVICE S. Appleton

Renewal June 1902

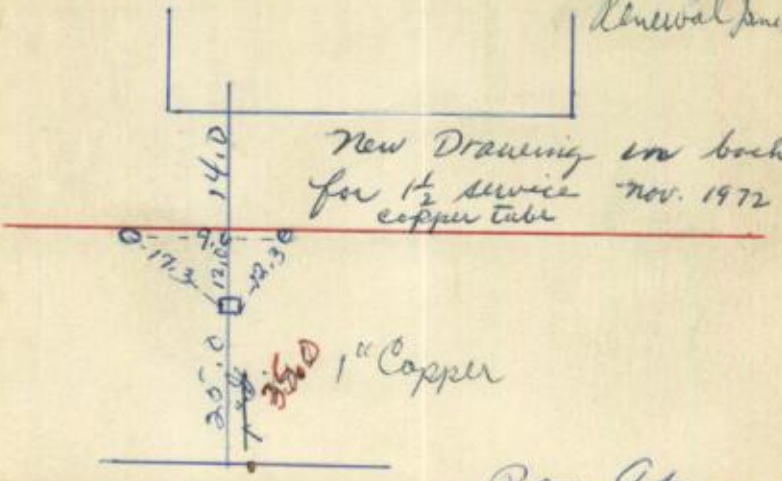

Ren Apr. 1914

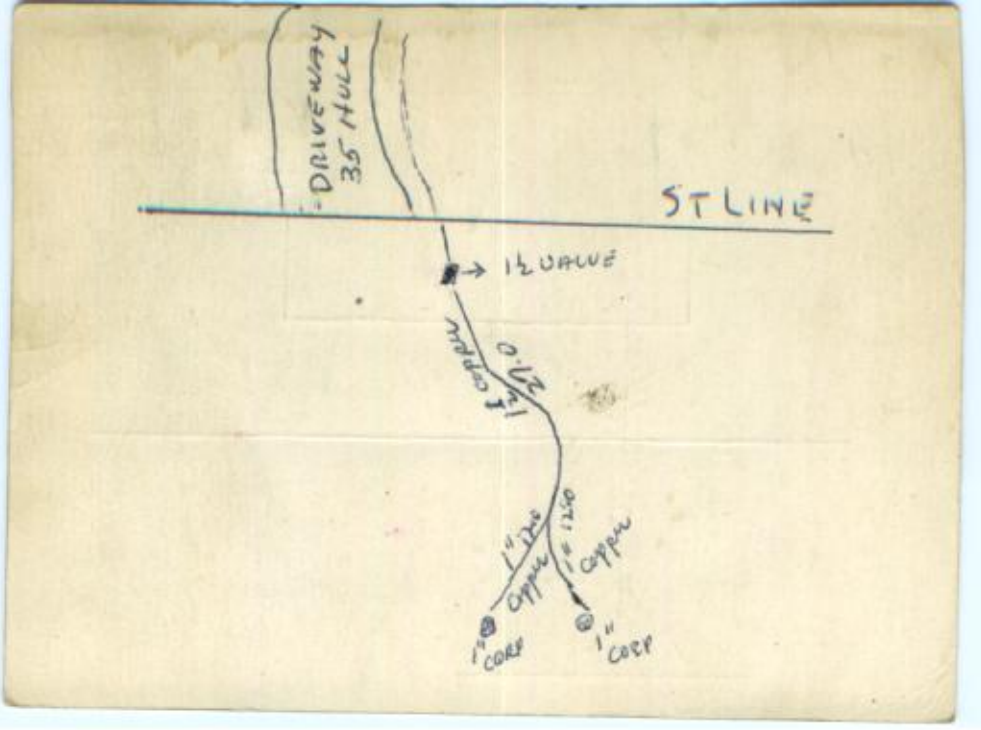
DRIVEWAY
35' HULL
ST LINE
1½ VALVE
1" COPPER
1" COPPER
1" COPPER
1" CORP
1" CORP

No. 38 Hull St, Henham STREET | APP. No. 10337

Inst. 5/8/61 LOCATION OF SERVICE Ruth M. Thompson

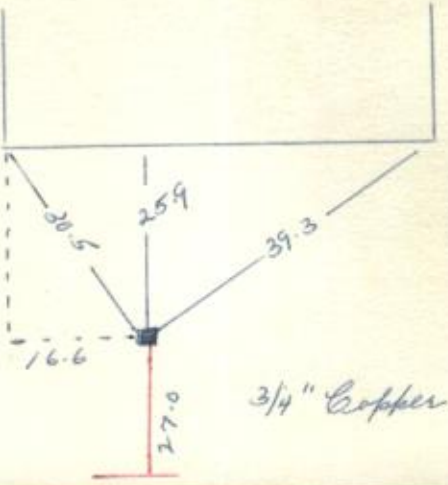

No. 38 Hull | STREET | APP. No. 9042

Sept 20, 1962 LOCATION OF SERVICE Installed 1955

New Tap

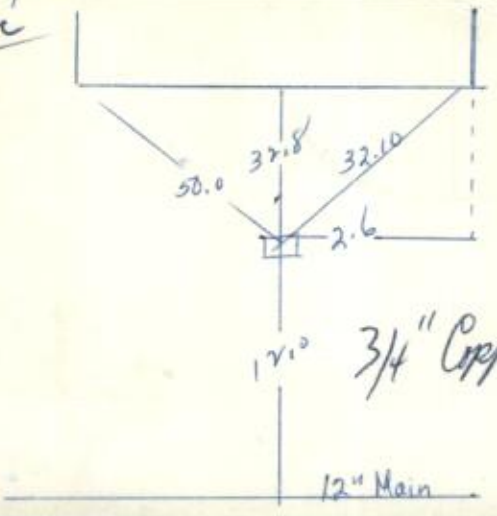

No. 40 Hull (Wenham) STREET APP. No. 6898

G.H.R. July 20 1939

D.H LOCATION OF SERVICE M. F. Brennan

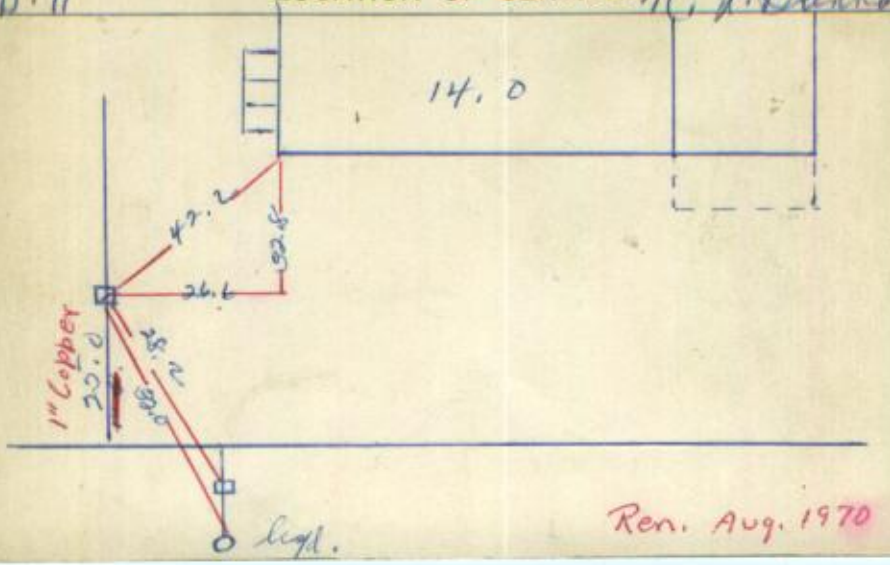

Ren. Aug. 1970

No. 40 Hill STREET APP. No. 8576

Sept 17 1952

D.H. LOCATION OF SERVICE Donald Cam

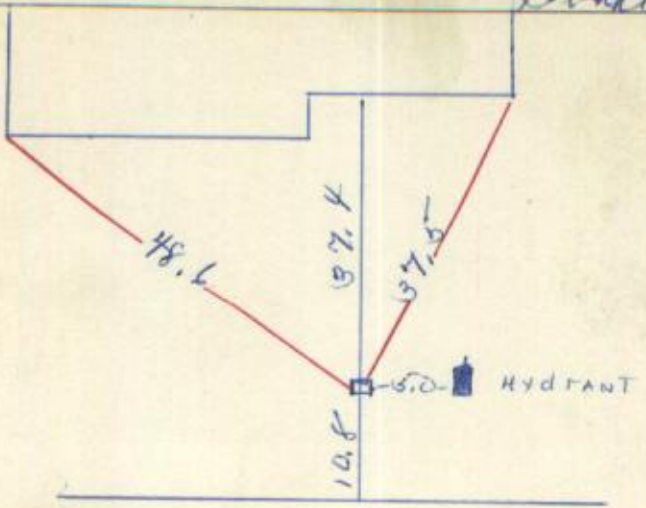

No. 40 rear Hull 8 (Wenham) STREET | APP. No. 11220

New Service LOCATION OF SERVICE Brennan

Oct 2, 1969

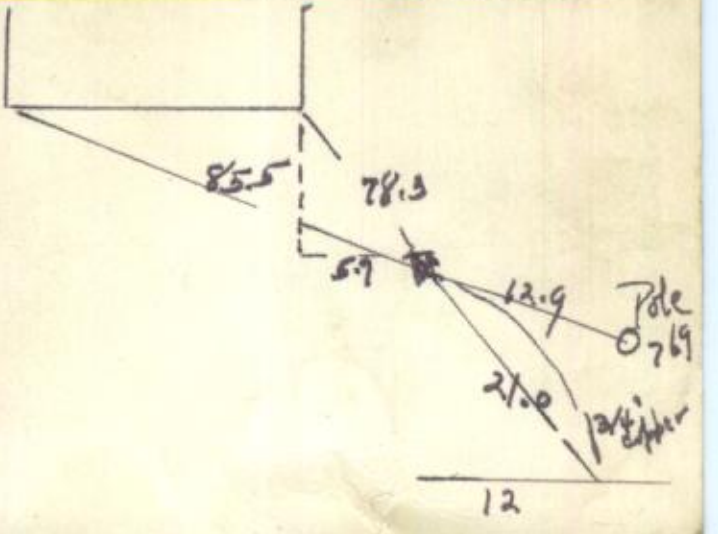

No. 42 Hull S | STREET | APP. No. 8462

New Service, Ar LOCATION OF SERVICE

#40 R. Hull, Wenham

Aho, Arnold D. et ux

June 5, 1952

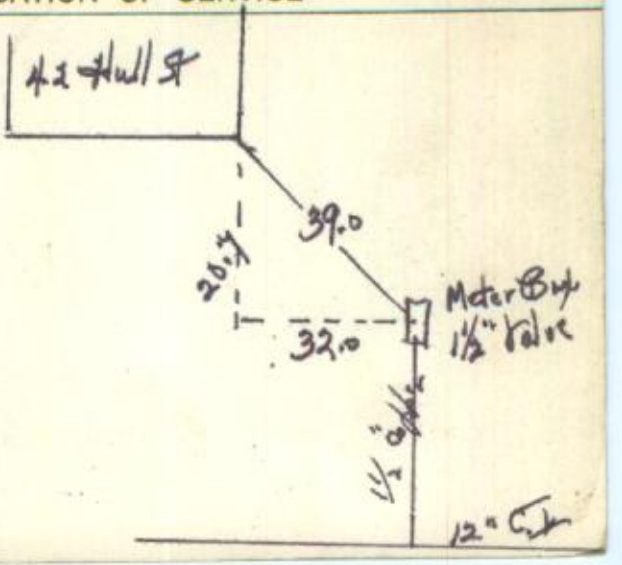

No. 42 Hill STREET APP. No. 8462

LOCATION OF SERVICE Installed 1952
Renewed (1962)

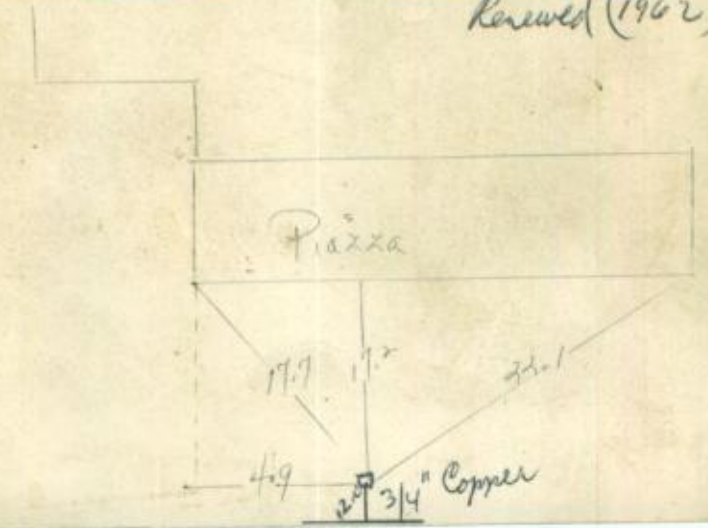

No. 48 Hull (Wexham) STREET APP. No. 8583

Oct 4, 1952

D.H LOCATION OF SERVICE K. Kinsman

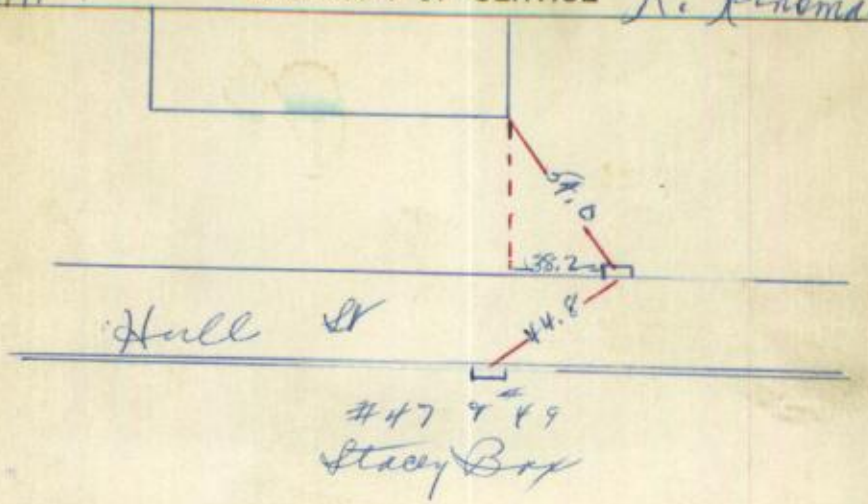

No. 53 Hall St | STREET | APP. NO.

LOCATION OF SERVICE

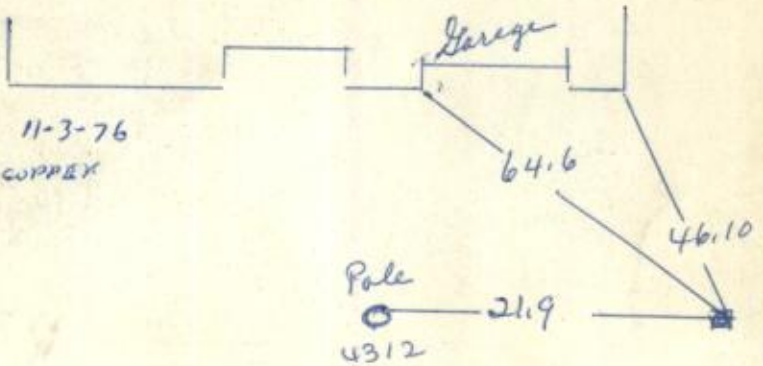

INSTALLED 11-3-76
10' OF 3/4 COPPER
3/4 CORP.

No. 55457 Hull St STREET | APP. No. 10849

LOCATION OF SERVICE

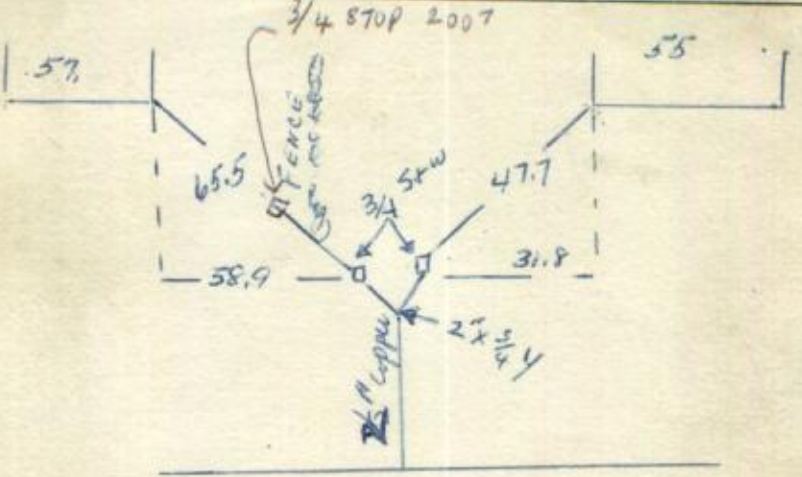

Measures for No. 57 Hull (#55 Has no Door at present time) | STREET | APP. No. 10849

New Loc - May 10, 1961 LOCATION OF SERVICE Francis Roberts

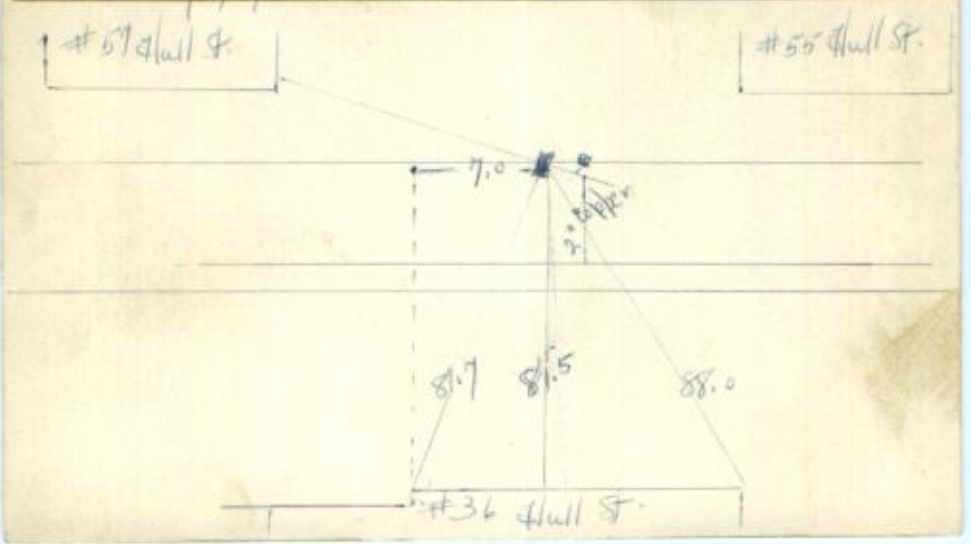

No. 59 Hull STREET APP. No. 10867

Service comes off LOCATION OF SERVICE Roberts + Marshall Inc

Neal St

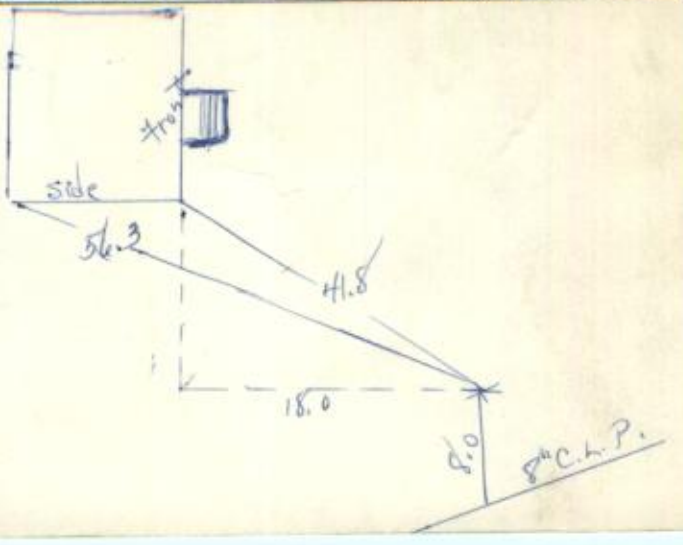

INSTALLED
1966

for B.

No. 60 Hull STREET | APP. No. 8472

May 6 1952

D.H LOCATION OF SERVICE Bernard W Hawkins

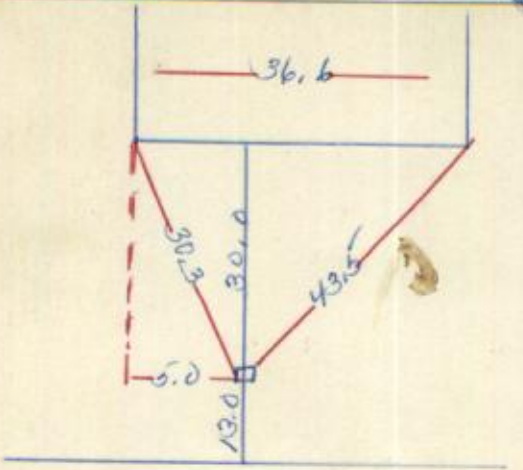

1-29-00 LEAK ON SVC 1" CORP & 2' OF 3/4 COPPER

No. 61 Hull St (Servd. off Newst. front of Hull) STREET APP. No. 10997

LOCATION OF SERVICE

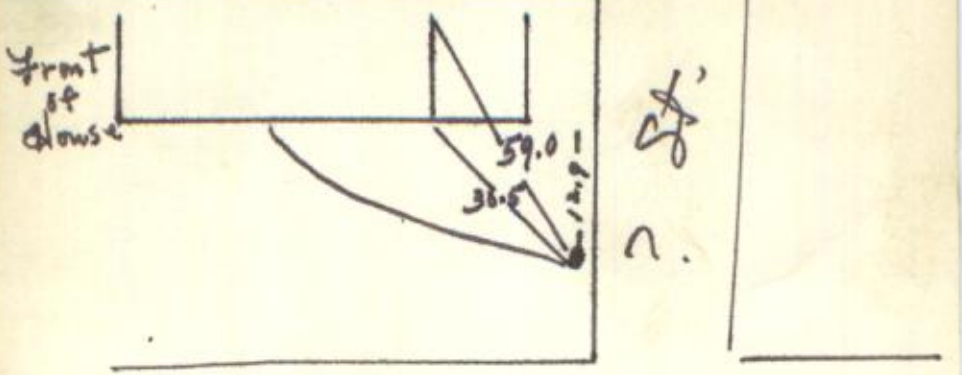

No. 66 Hall STREET. APP. No. 1800

C.P. April 23 1884

D.H. LOCATION OF SERVICE. Martha Brady

Renewed June 21, 62

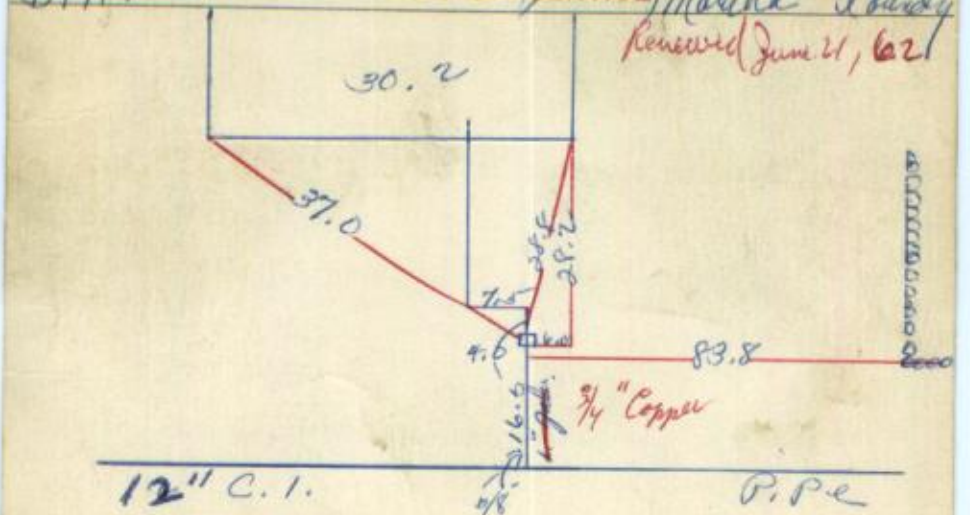

6/21/58 - Dug S & W
Another gas copper
to Slay.
Probed good.

No. 67 Hull STREET APP. No. 5164

April 1884

D.H LOCATION OF SERVICE (6) Forrest Flats

Renewed June 21, 62

6-21-62
3/4 COPPER
HOUSE TO S&W

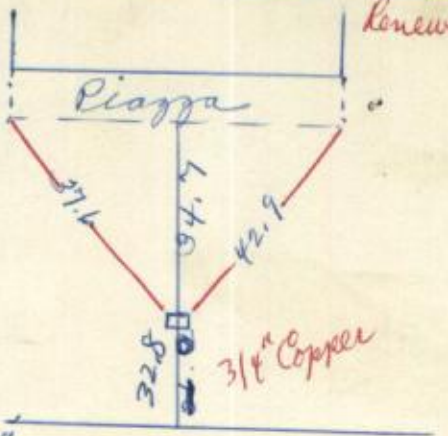

off water House Keeper 2/20/95
Police Called

No. 69 Hull STREET APP. No. 1801

New Loc. Aug 4 1961 LOCATION OF SERVICE Hughes White

Removed June 22, 62

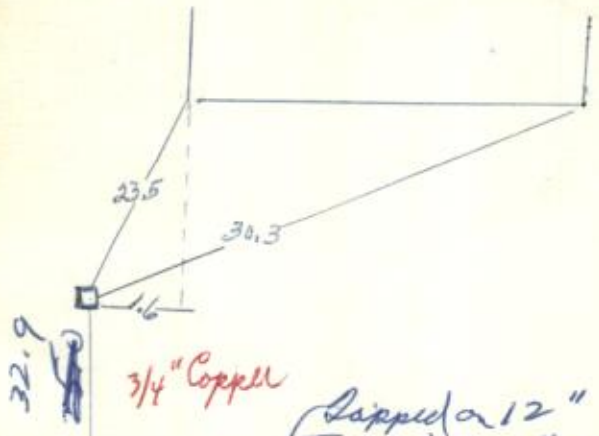

No. 173 Hull | STREET | APP. No. 6800

Aug. 31, 1926 LOCATION OF SERVICE Rob't H. Dickinson

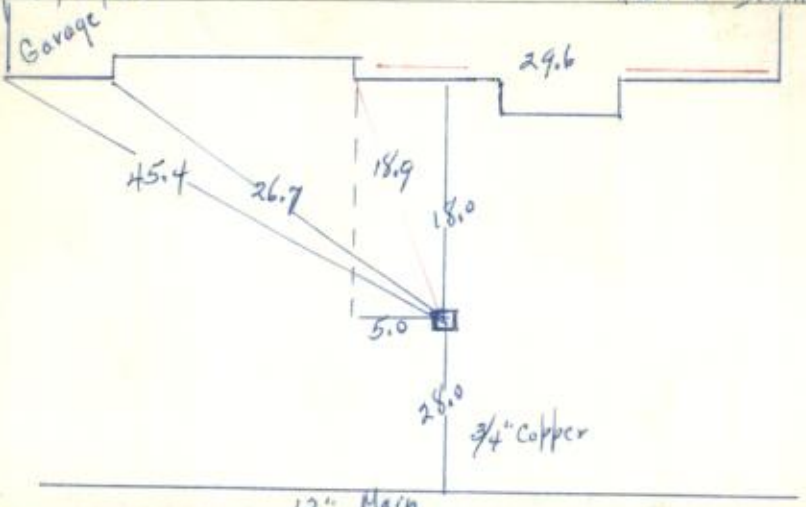

No. 75 Hull STREET | APP. No. 10,447

Mar 22, 1962 New S. LOCATION OF SERVICE

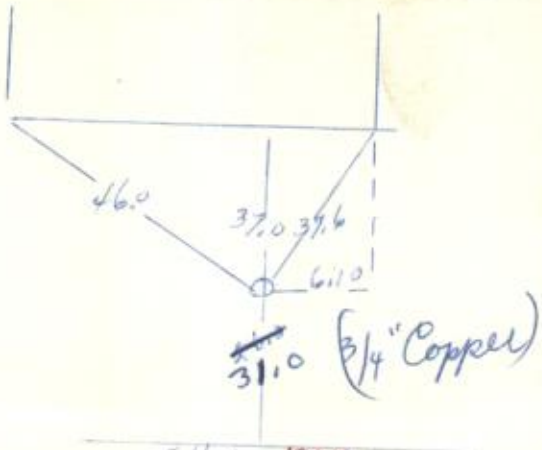

No. 81 Hull STREET | APP. No. 10,446

Jan. 30 196x LOCATION OF SERVICE

New Service

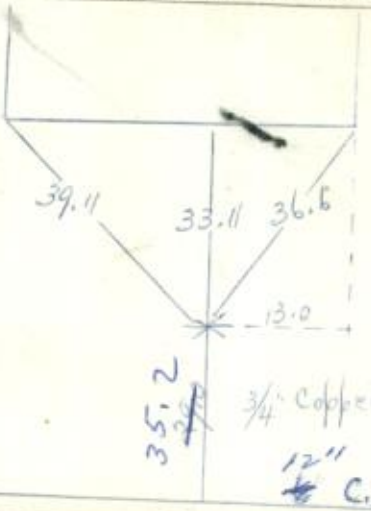

85-87
No. ~~95~~ Hull St | STREET | APP. No. 5405

McKeans House | Rec 1959

LOCATION OF SERVICE

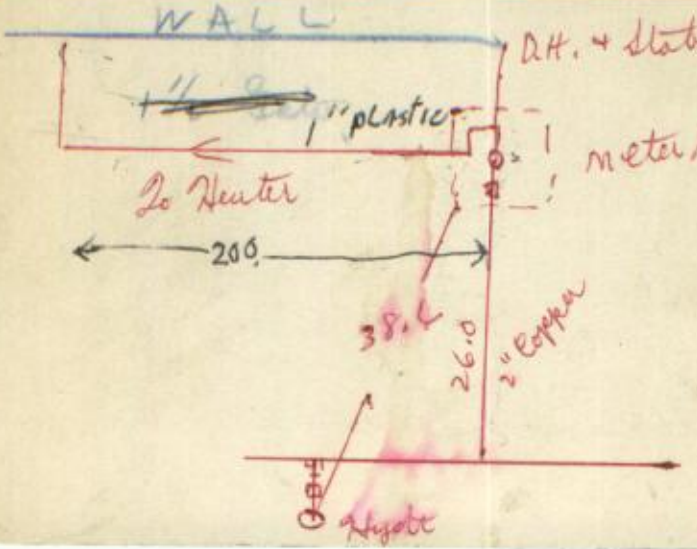

No. 90 Hull STREET APP. No. 7211

Feb 28, 1947

LOCATION OF SERVICE Clifford Chapman

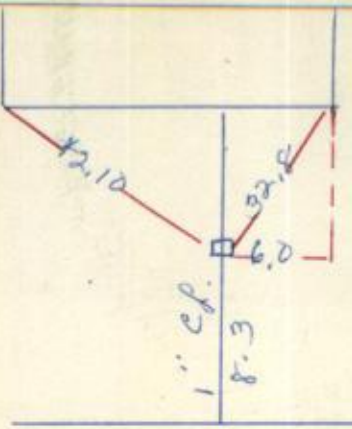

BROKEN SVC REPLACED WITH 3/4 COPPER

No. 92 Hull St | STREET | APP. No. 9/16/09

LOCATION OF SERVICE

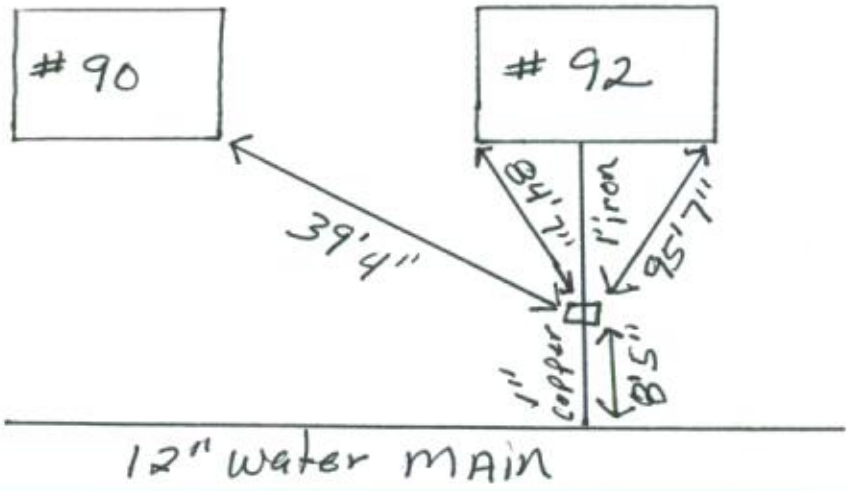

Replace water service 7/16/09
1" copper main to property Line
1" iron to House at Property
at Wall

No. 93 Hull St Lot 6 | STREET | APP. No.

LOCATION OF SERVICE

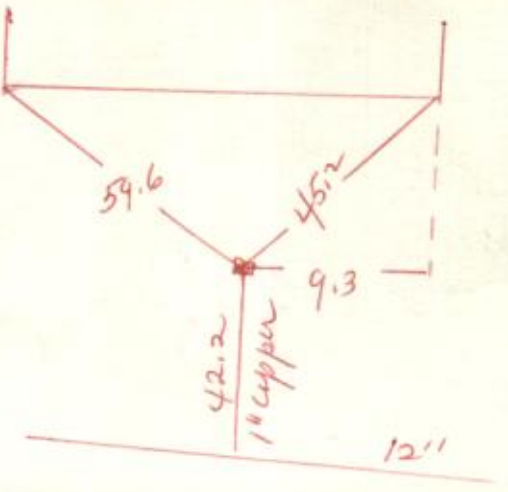

No. 95 Hull St | STREET | APP. No.

LOCATION OF SERVICE

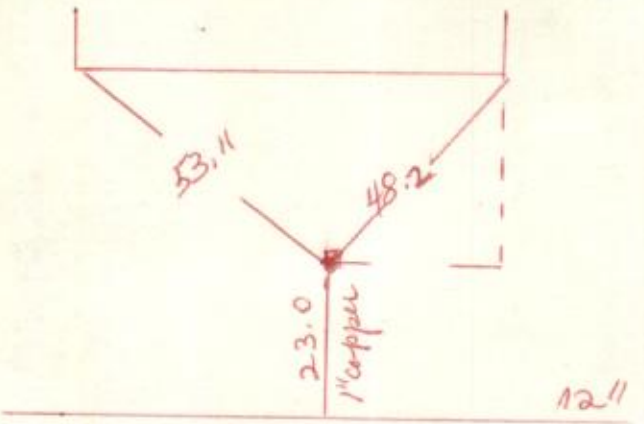

No. 95 Hull St. STREET | APP. No. 11789

LOCATION OF SERVICE

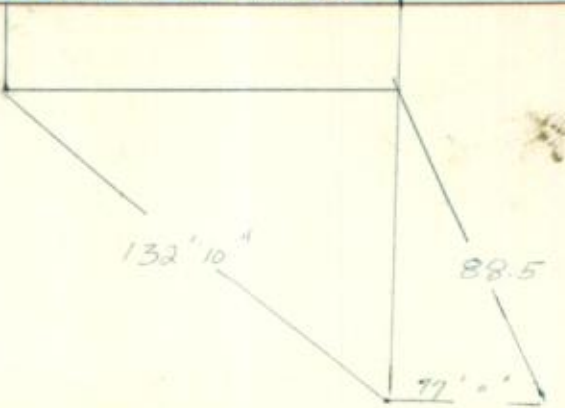

No. 95 Hull Street | App. No. 8281

McKeon

Garden

Serv.

LOCATION OF SERVICE

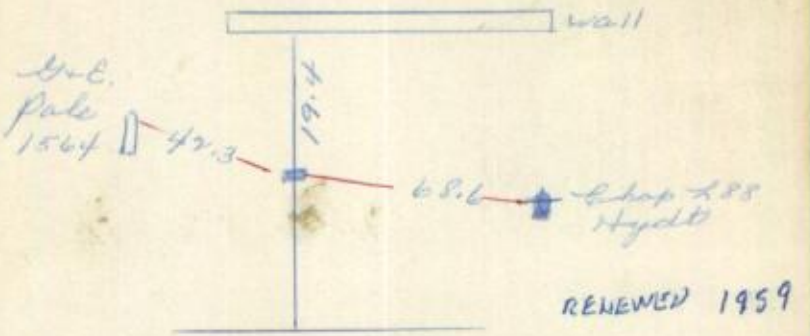

RENEWED 1959

No. 95-REAR- HULL-ST ~~STREET~~ | APP. No.

LOCATION OF SERVICE

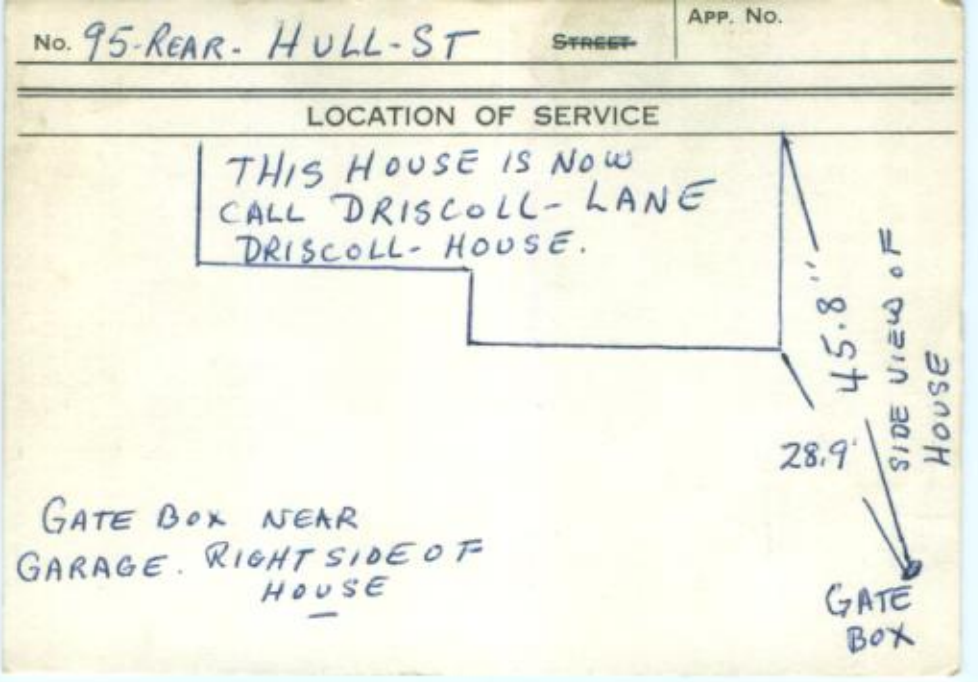

No. 101 Hull ST. | STREET | APP. NO.

LOT #3

LOCATION OF SERVICE

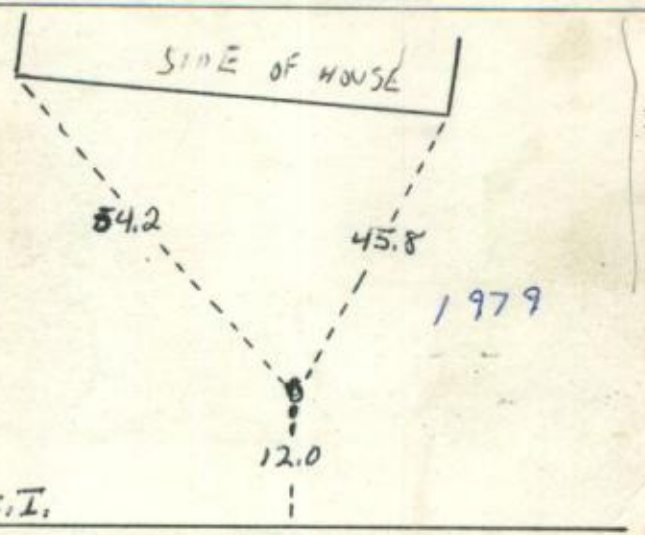

No 103 Hull ST. | STREET | APP. No.

LOT # 2 LOCATION OF SERVICE

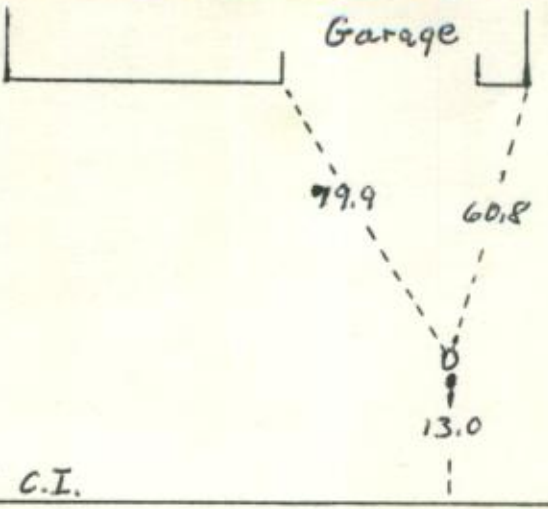

No. 105 Hull ST. | STREET | APP. No.

LOT # 1

LOCATION OF SERVICE

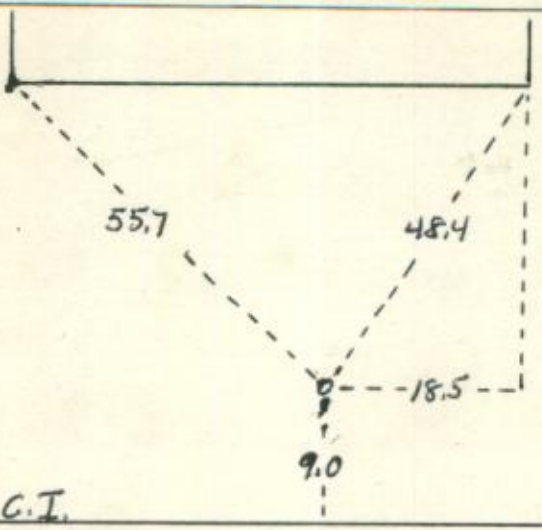

No. 106 Hull (Corner Temi Rd) STREET | APP. No. 10,330

New Service

LOCATION OF SERVICE

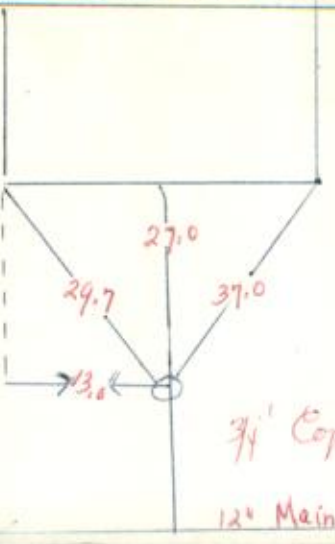

No. 110 Hull STREET | APP. No. 9774

Jeffrey

LOCATION OF SERVICE East 1958

No. 112 Hull St. STREET | APP. No. 10336

4/20/61 Inst. LOCATION OF SERVICE David S Larsen

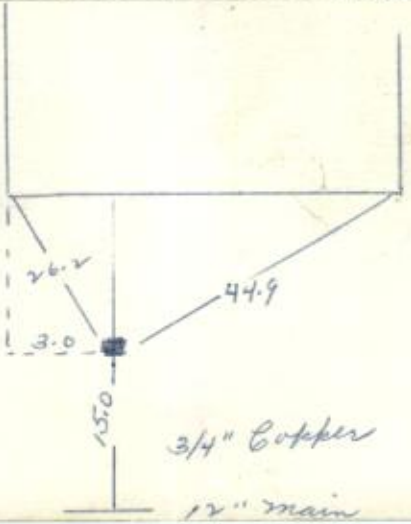

No. 114 Hull St STREET | APP. No. 11609

LOCATION OF SERVICE 6-2-78

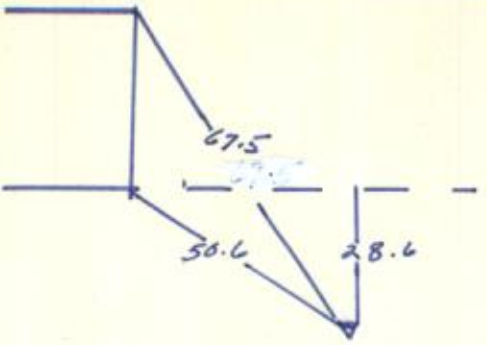

No. 118 Hall St | STREET | APP. NO.

LOCATION OF SERVICE

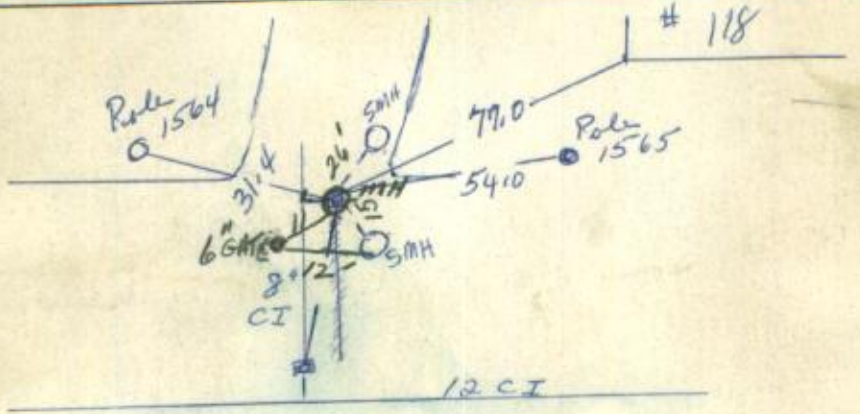

No. 118 Hull STREET APP. No. 10,649

May 18, 1964 LOCATION OF SERVICE

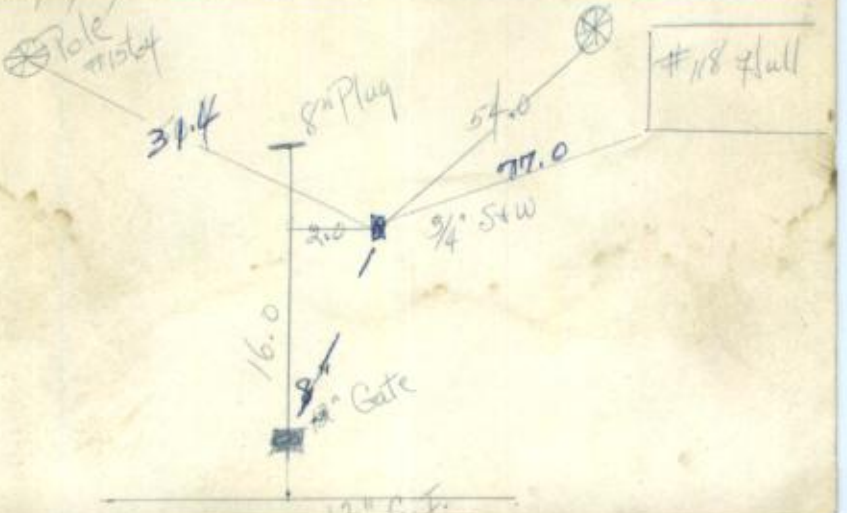

No. 120 Flatt Street | App. No. 10,615

New Serv. - Temp. Inc. **LOCATION OF SERVICE**

Sept. 5, 1963
Mtr. Type #506

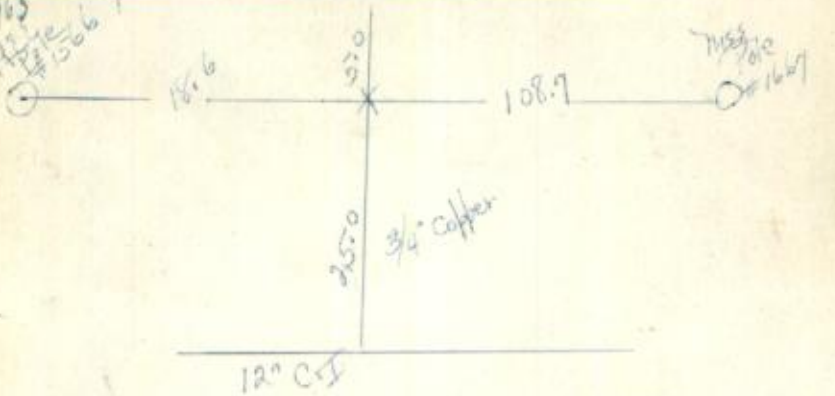

No. 122 Hull STREET APP. No. 10,616

LOCATION OF SERVICE

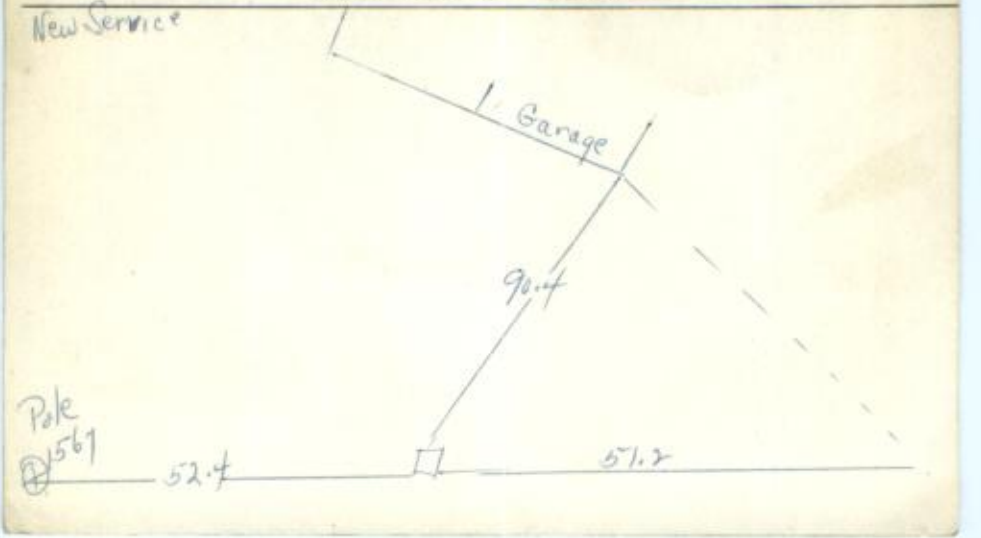

No. 124 Hull | STREET | APP. No. 10,617

Sept. 5, 1963 New Serv. LOCATION OF SERVICE (N)

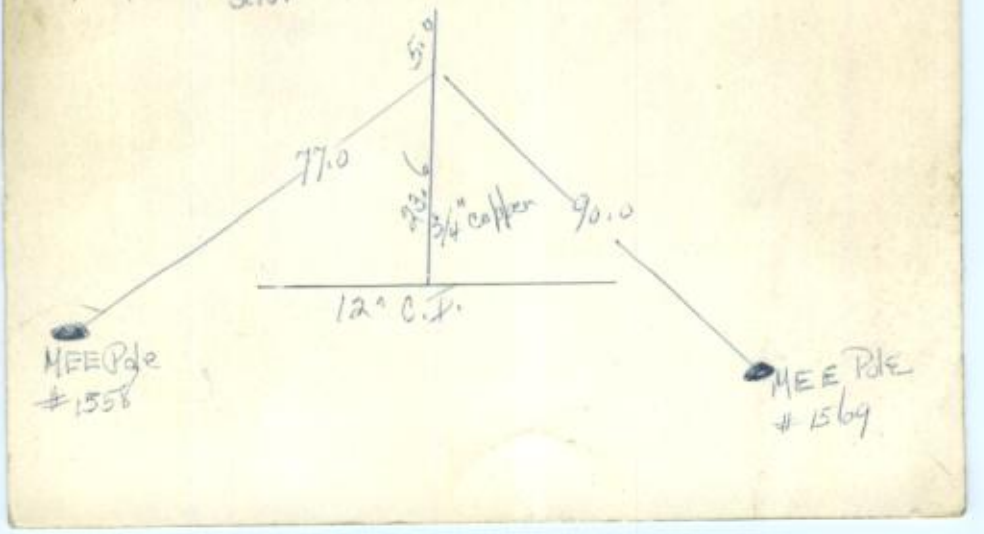

No. Hall | STREET | APP. No. 6653

July 21, 1932

J. W. B. garden

LOCATION OF SERVICE

(Service Dise 1960)

~~3 years~~

M C Keans Kennels

No. 4 Hull (Wenham Line) STREET | APP. No. 6768

J.W.B. Apr. 30, 1936

D.H LOCATION OF SERVICE P. G. Wells.

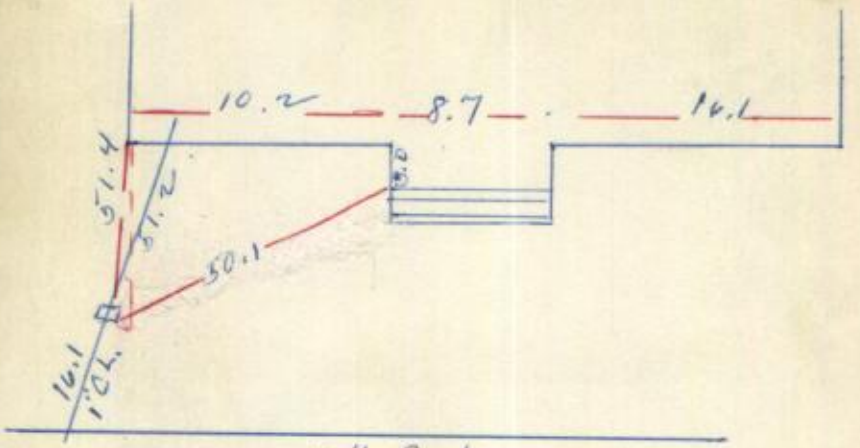

No. Hull (Wenham Line) STREET | APP. No. 6972

Q.H.R July 23, 1940

D.H LOCATION OF SERVICE W. E. Shatheimer

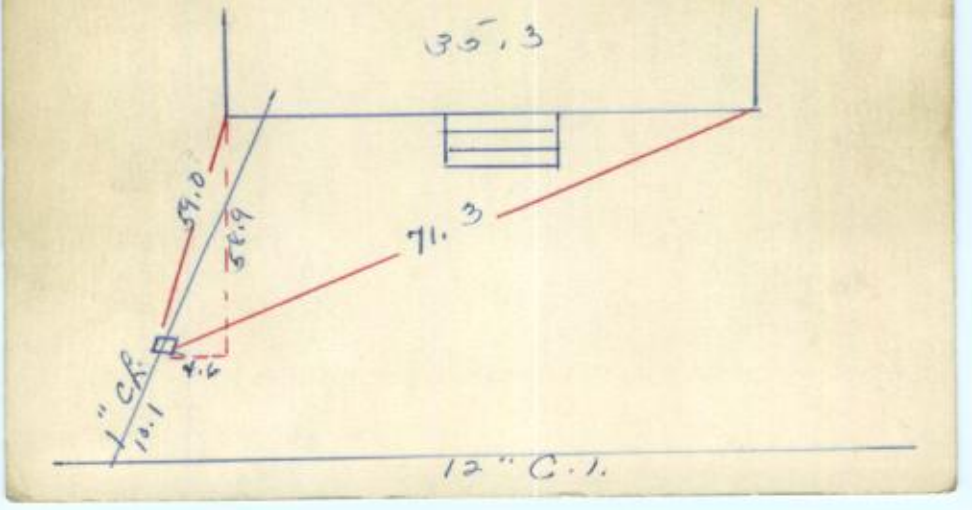

No. Hull | STREET | APP. No. 6784

J. W. B. | Sept 9, 1926

garden | LOCATION OF SERVICE Langan McLean

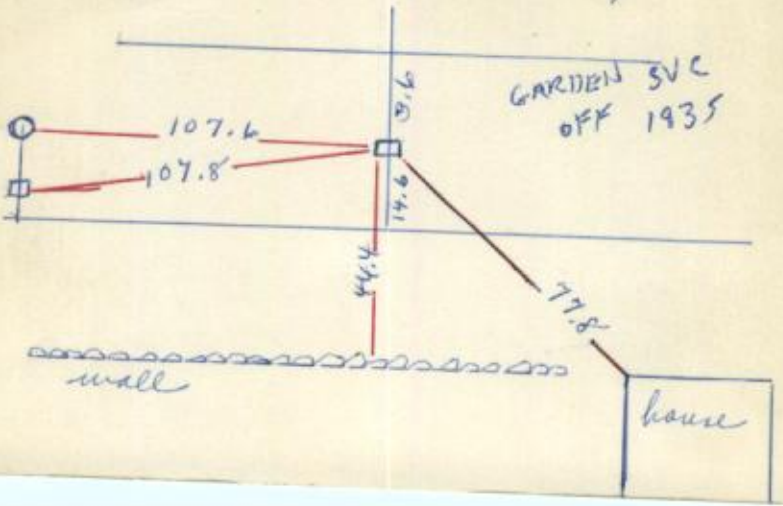

No. HULL-ST. DRISCOLL LANE Street | App. No.

LOCATION OF SERVICE

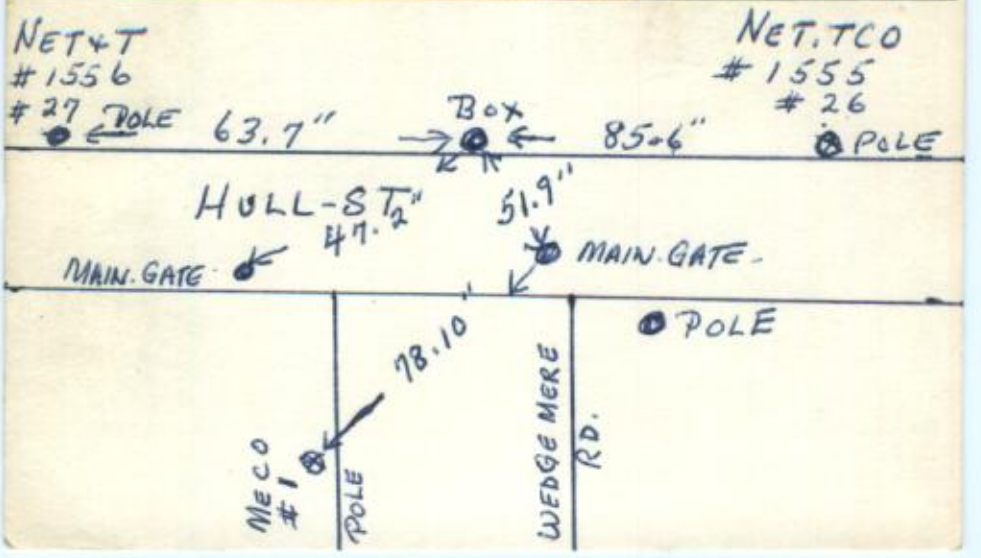

No. 1 Preston Place STREET | APP. NO. 2623

LOCATION OF SERVICE

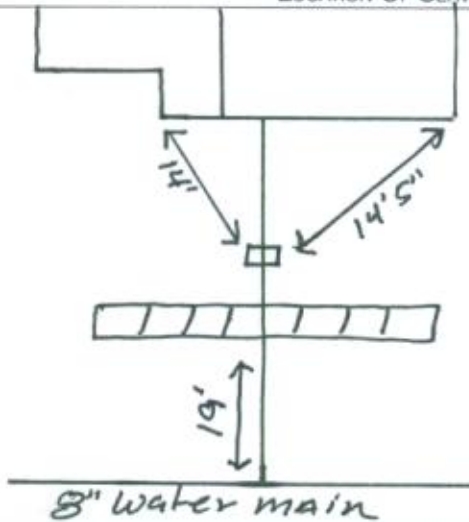

7-20-10
Replaced
1" top 1" copper
main to property
3/4 copper property
To House

No. 8 Preston Place | STREET | APP. NO.

7-12-10 Replaced

LOCATION OF SERVICE

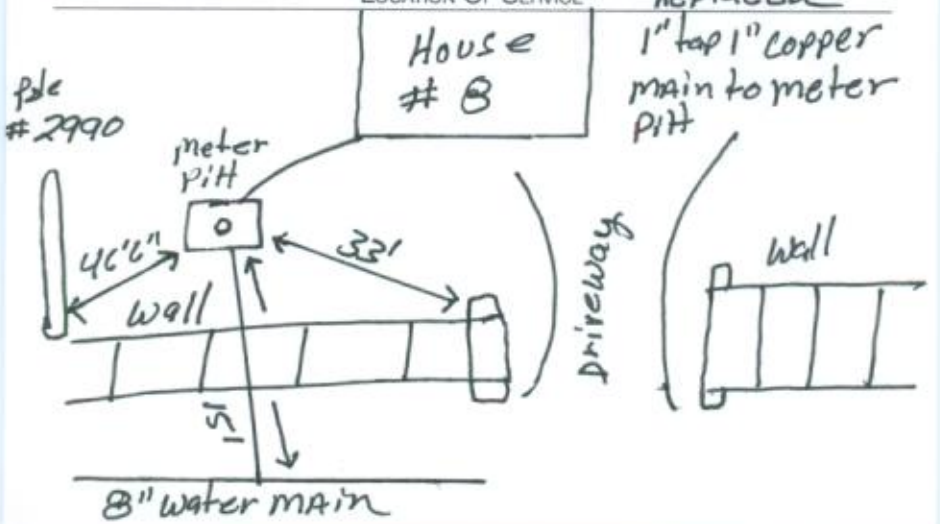

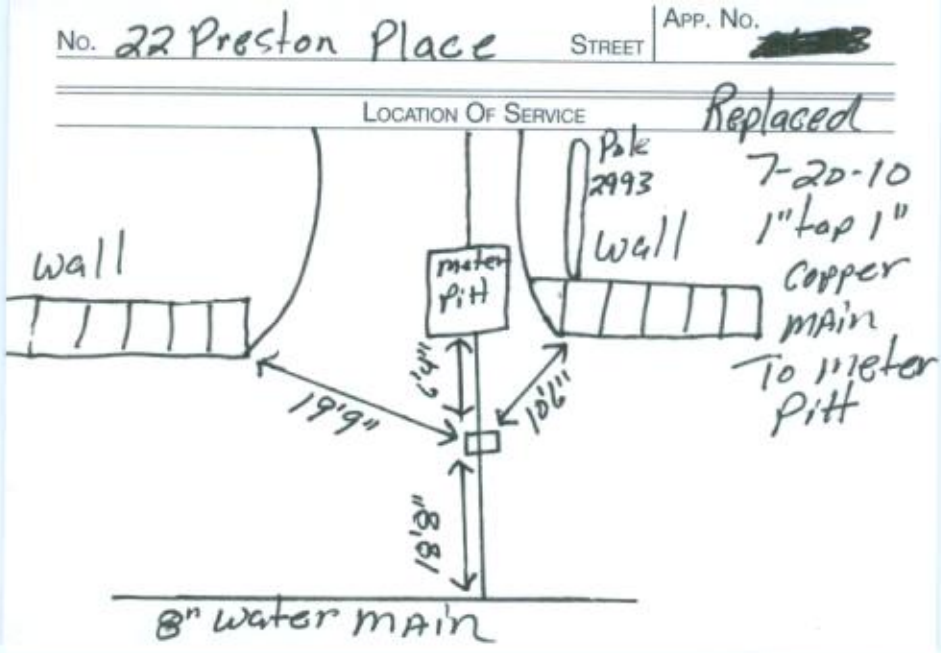
No. 22 Preston Place
STREET
APP. NO.
[redacted]
LOCATION OF SERVICE
Replaced
7-20-10
1" top 1"
Copper
main
To meter
pit
Pole
2993
wall
wall
meter
pit
19'9"
6'4"
10'6"
18'8"
8" water main

No. Preston Place #30 STREET | APP. No. 11303

Renewal 1972 Wigglesworth Driveway

LOCATION OF SERVICE (N. Clement)

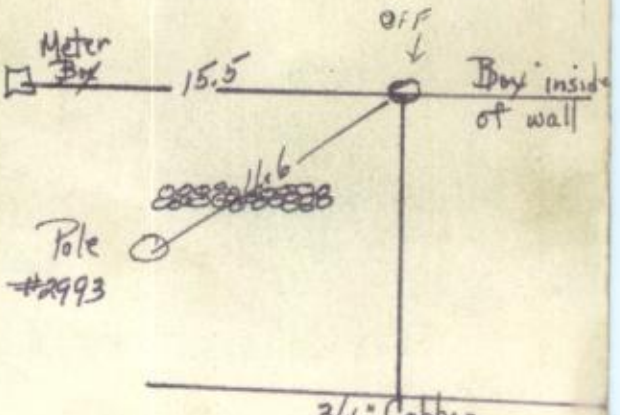

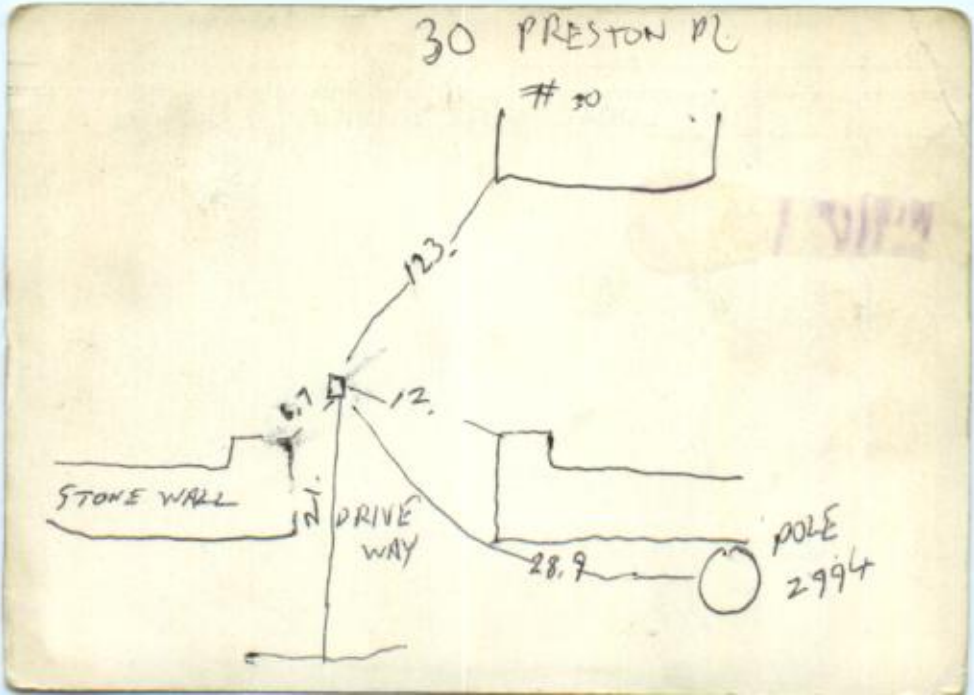
30 PRESTON PL
#30
123.
6.7
12.
STONE WALL
2
DRIVE WAY
28.9
POLE
2994

No. 30 Preston Place STREET | APP. NO. Davis

LOCATION OF SERVICE

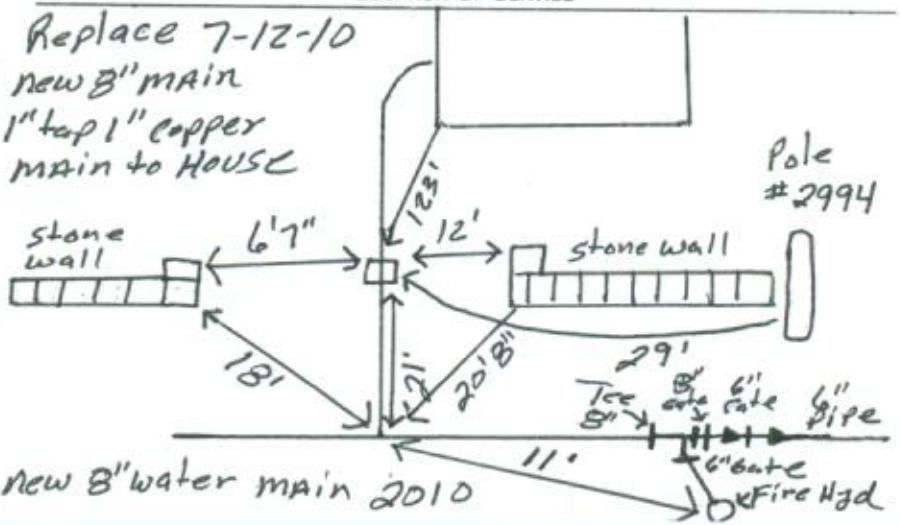

No. 35 Preston Place STREET | APP. NO.

LOCATION OF SERVICE Replaced 7-12-10

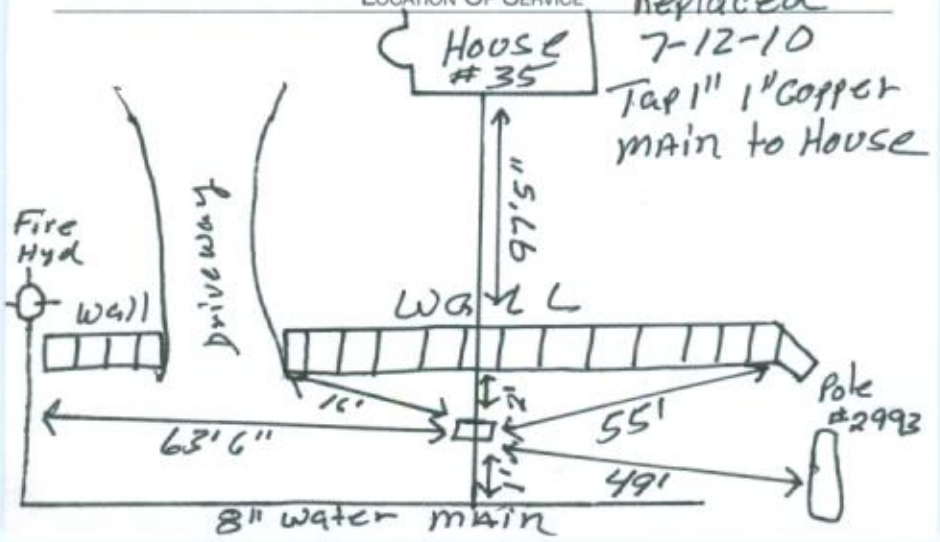

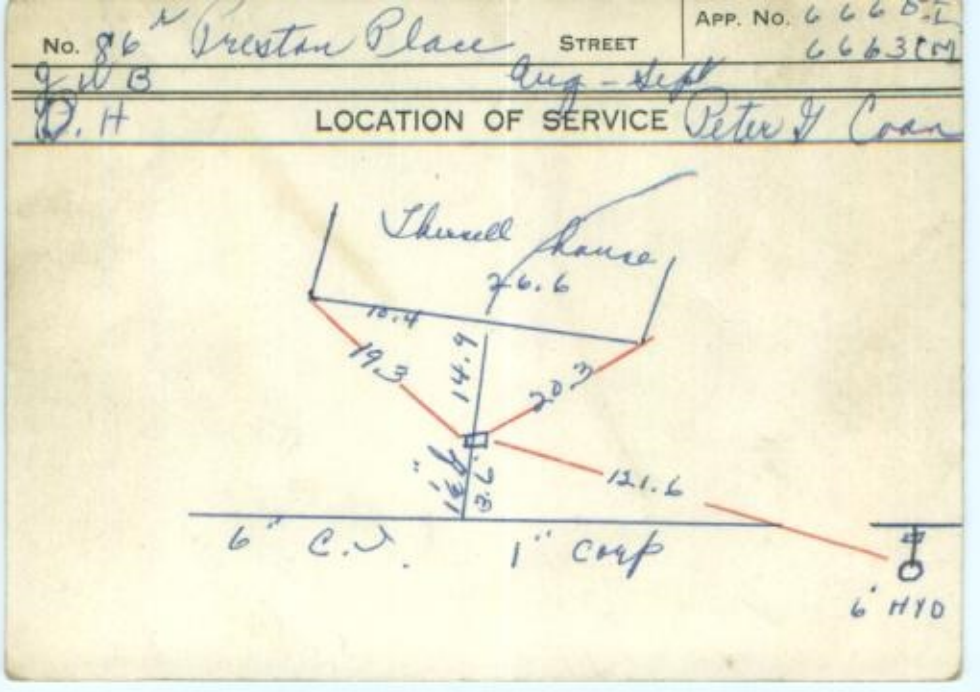

Off at main 12/16/15
new service fed from preston place curb box in shared driveway with 88

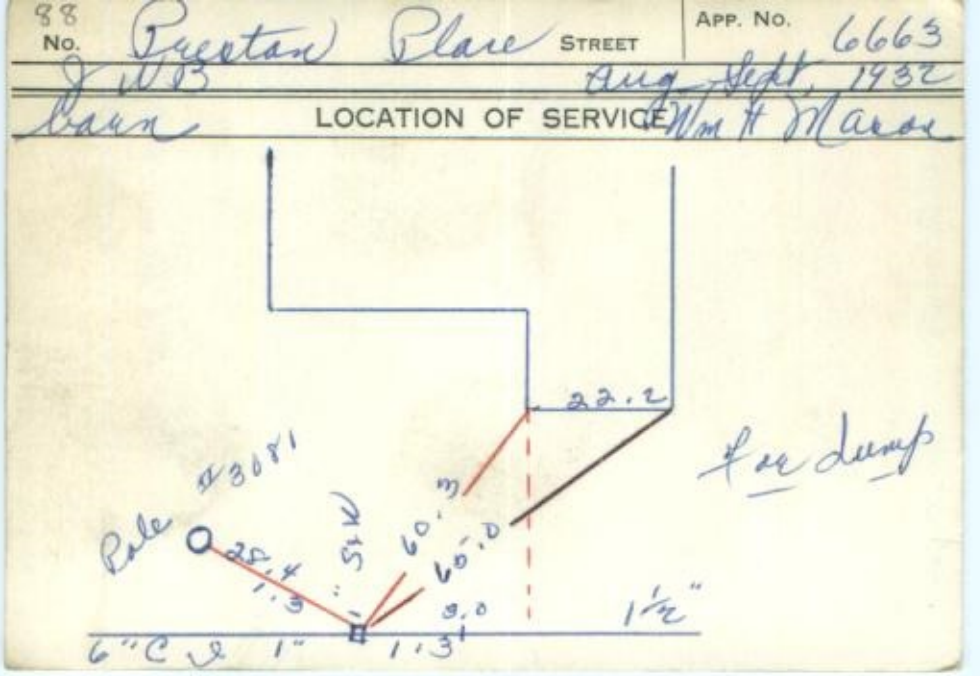

6" main killed 12/16/15
line to dump killed 12/16/15

No. 89 Preston Place STREET APP. No. 10,761

June 7 1965 LOCATION OF SERVICE
New Service

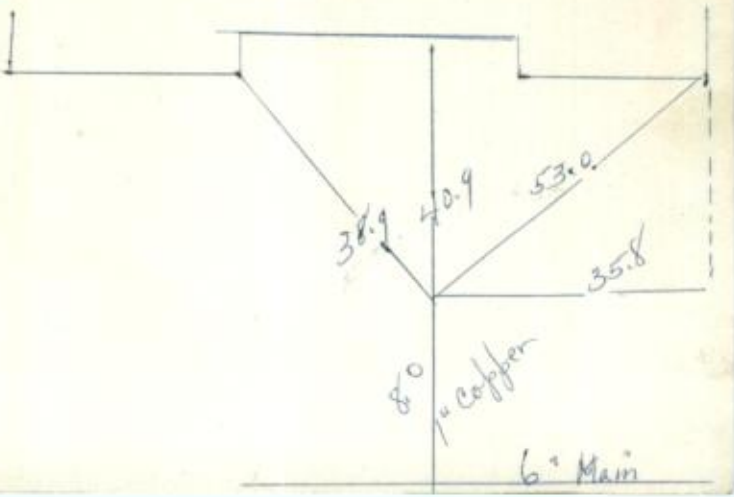

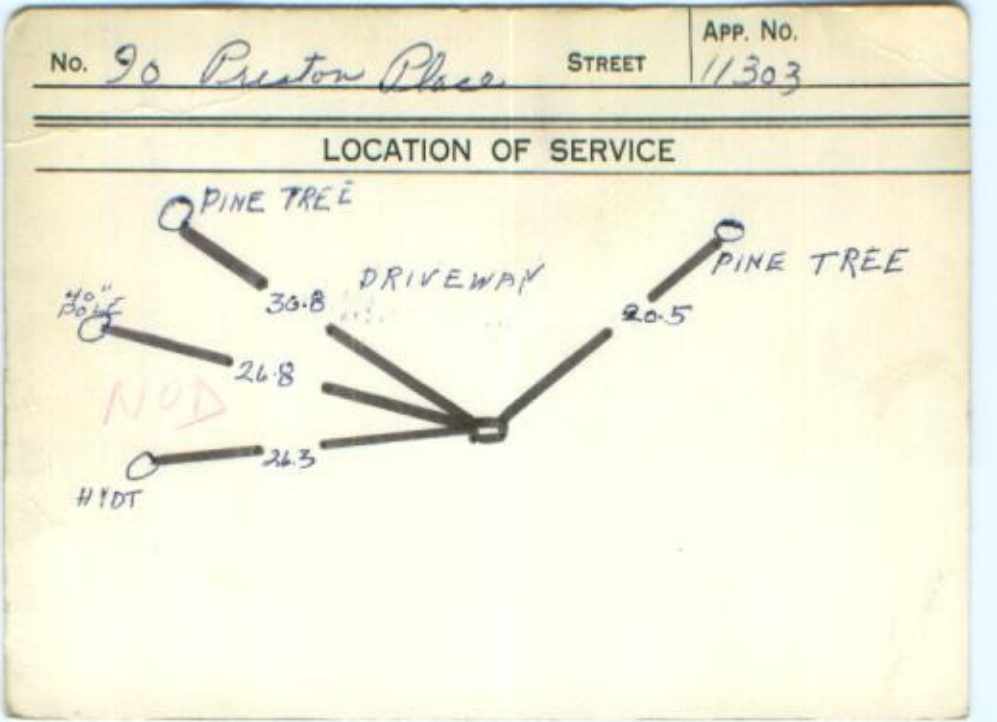

Off at main 12/16/15

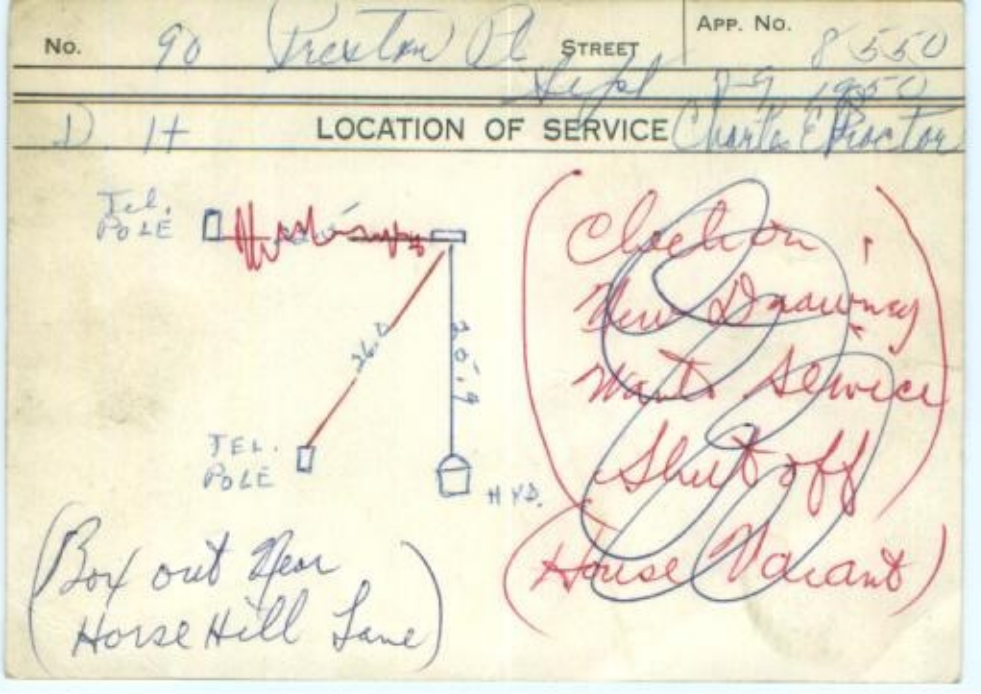

Off at main 12/16/15

No. 91 Preston Place STREET APP. No. 10,758

June 7, 1965 LOCATION OF SERVICE Ronald A. Tarr

New Service

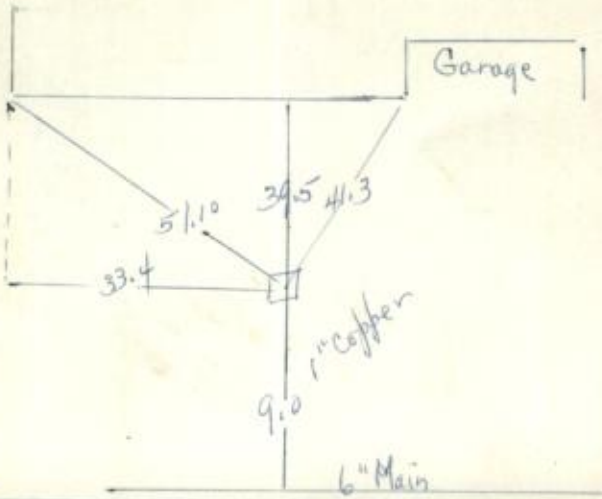

No. 94 Preston Place STREET APP. No. 10,433

Chas J. Jesolo

Jan. 10, 1962 LOCATION OF SERVICE FAULKNER

New Service

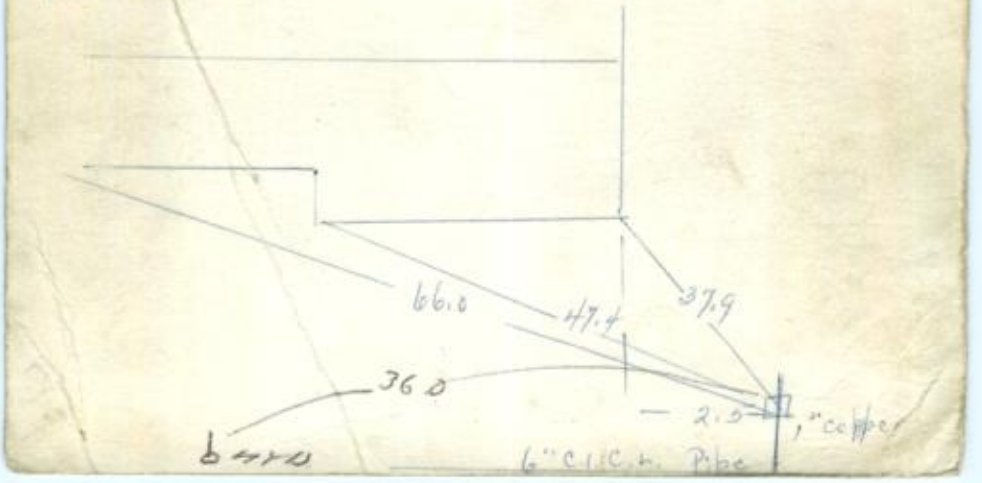

No. 96 PRESTON PL · STREET | APP. NO. 10425

JAN 10 1962 LOCATION OF SERVICE DOUG TERSOLD

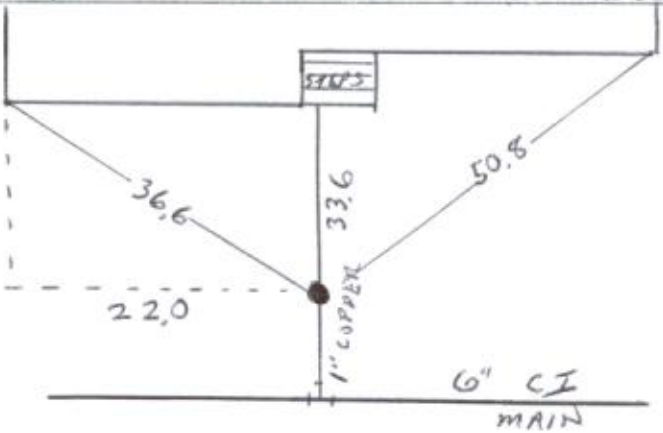

105
No. Preston Place STREET | APP. No. 8894

July 28, 1954

LOCATION OF SERVICE R S Clare

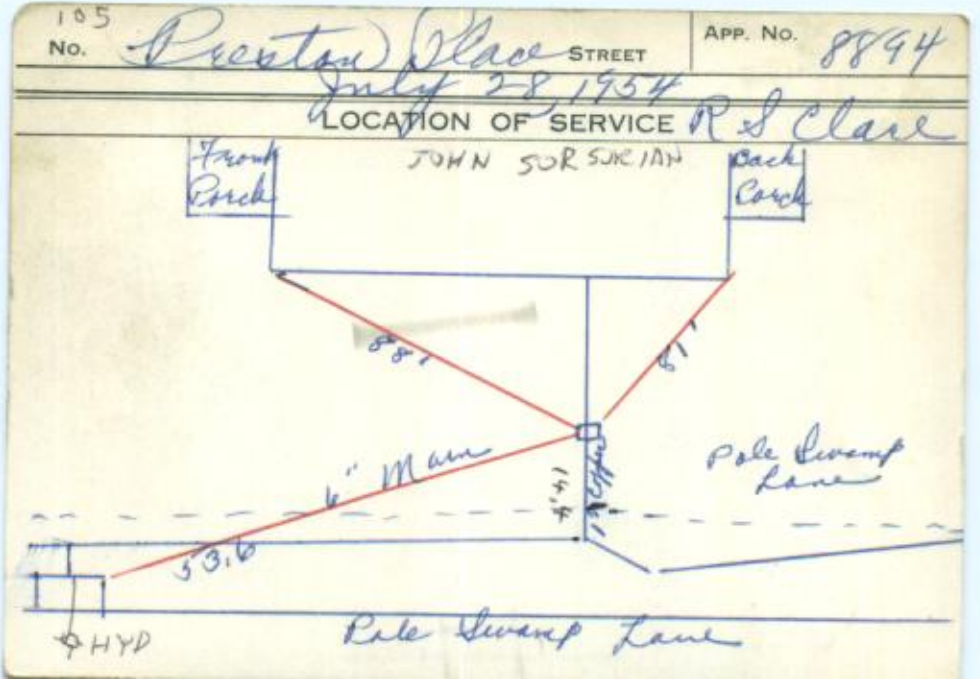

105 JOHN -JUDY
PRESTON SORSORIAN
PL

After #101

No. Kreston Place | Street | App. No.

LOCATION OF SERVICE

Standpipe put in frozen main bet. 1st + 2nd Hydt from Harsenhill Lane

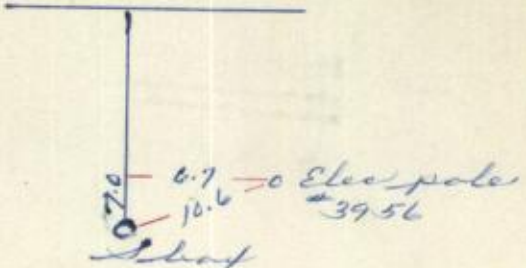

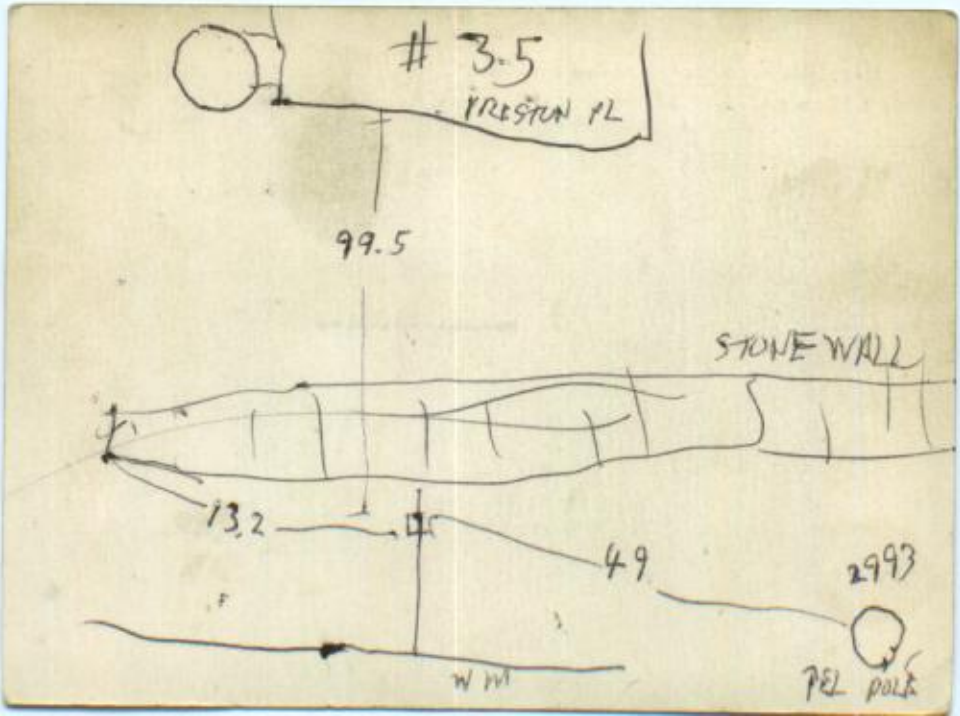
3.5
PRESTON PL
99.5
STONE WALL
13.2
49
2993
W IM
PEL POLE

No. Preston Place STREET APP. No. 4532

L.W.B. Sept 1992

D. H. LORING LOCATION OF SERVICE Cor. Preston Place (Hatch)

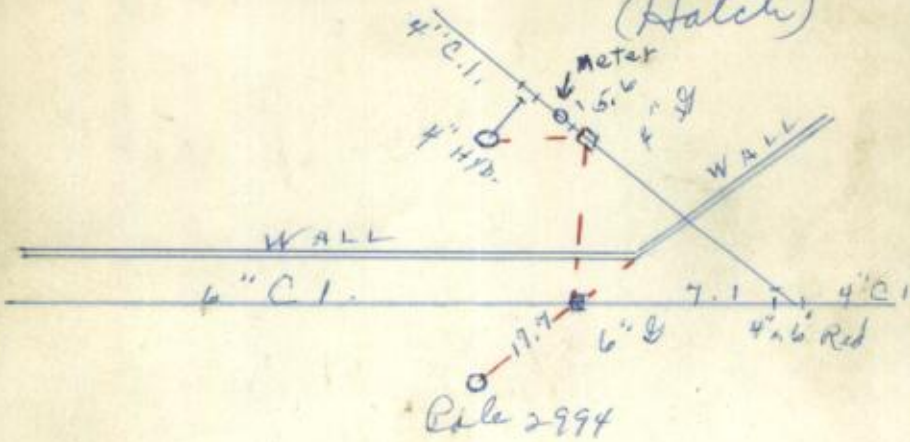

No. Preston Place opp Hatch's Driveway STREET APP. No. 10,496

July 16, 1962 ✓
New Services

LOCATION OF SERVICE

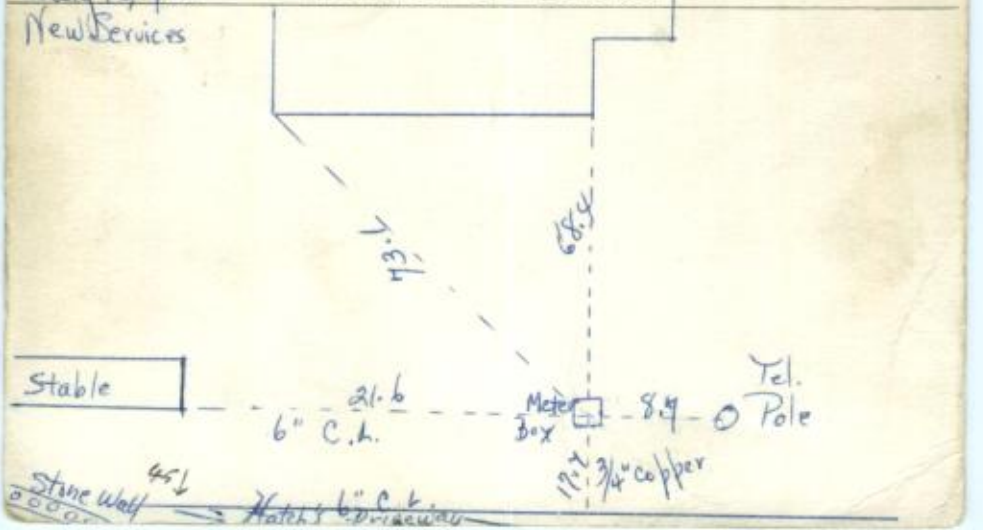

No. Rosetta Place STREET | APP. No. 6664

D.W.B. Dept 1932

B.H LOCATION OF SERVICE Edw. A Weiss

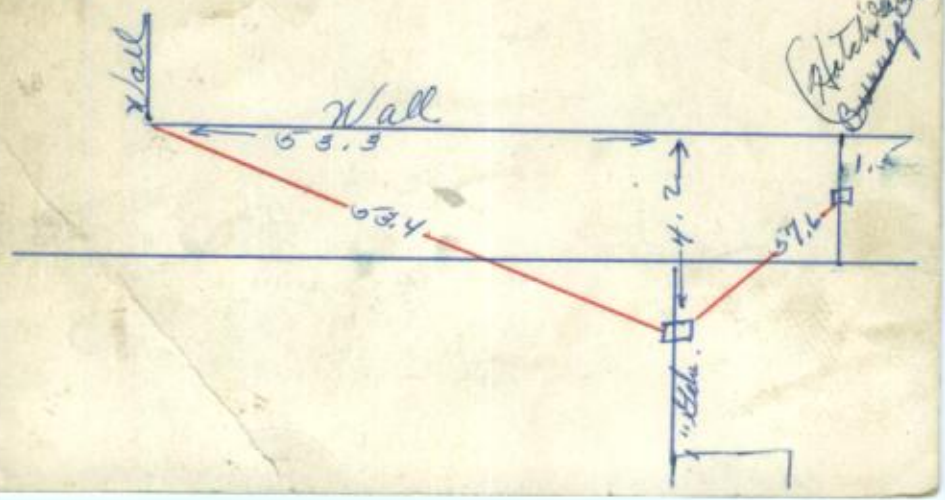

No. Preston Place STREET | APP. No. 6654

S W B — Sept 7, 1932

garden LOCATION OF SERVICE Francis H Hatch

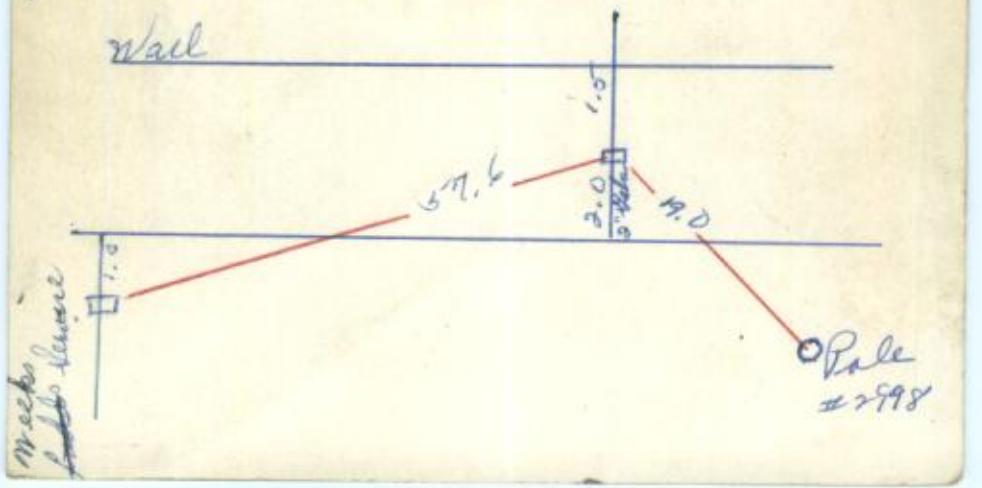

No. Brentan Place STREET APP. NO. 8219

L. H

Jan 23, 1951

D. H LOCATION OF SERVICE R. M (Cutler)

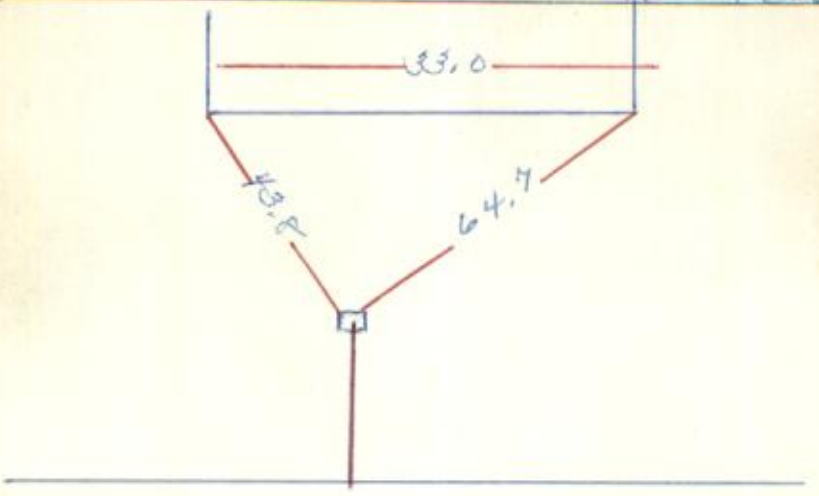

No. Preston Place STREET | APP. No. 8265

May 9, 1951

Garden Sera LOCATION OF SERVICE C. Canon

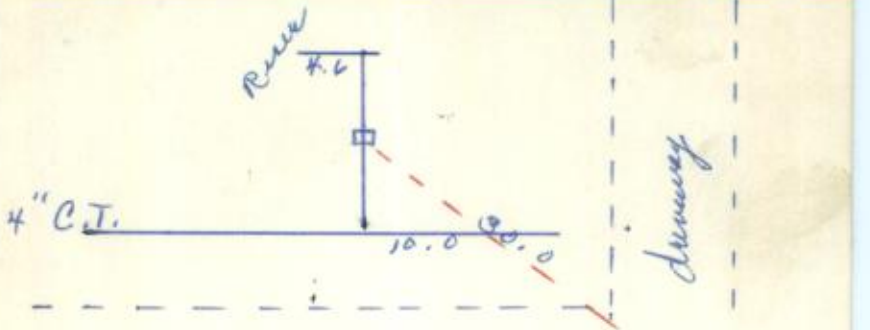

No. Preston Place STREET APP. No. 8892

July 28, 1954

LOCATION OF SERVICE E. J. Fish

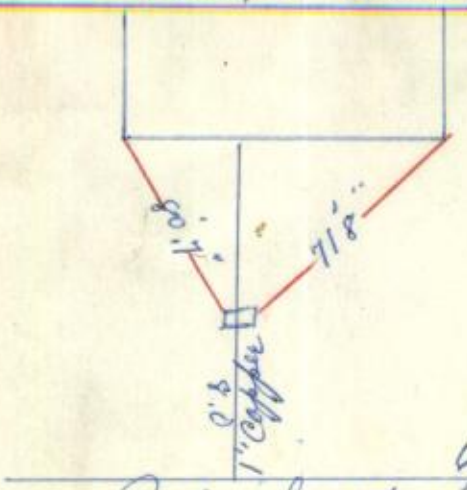

over

April 12, 77 Repaired
1 - 1" Curb Cock
2 - 1" Dresser sleeves
2 - 1" Gal. nipples
1 Curb Box

No. 5 Preston Place
Townsend & Poulton — STREET

APP. No. 9033

Dec. 10, 1963
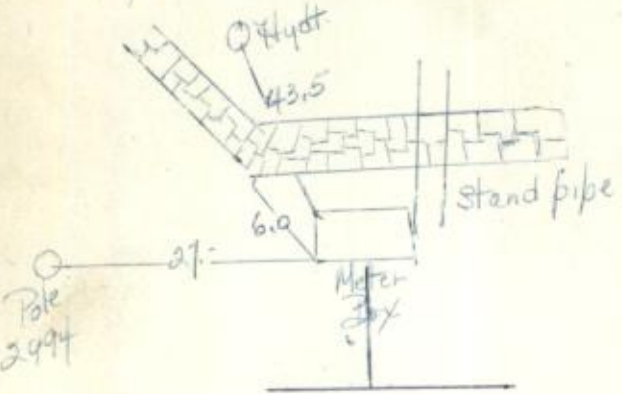
LOCATION OF SERVICE (14)